

Registration Statement

OF CLAIMANT OF RIGHT TO APPROPRIATE GROUND WATER

TO THE STATE ENGINEER OF OREGON:

I, Albert W. Marks
of 1250 Newberg High, Woodburn County of Marion
(Mailing address)
State of _____, do hereby make application for a certificate of registration as evidence of a right to appropriate ground water.

- Source from which water is withdrawn is Pump Well
(Flowing well, pump well, infiltration trench, or tunnel)
- Location is: 1 Mile S.W. of Woodburn
(Approximate distance and direction from nearest city or town)

and is more particularly described as follows:

(a) 7.8 chs. S 46.7° E from SE cor Dubois DLC 98
(Give distance and bearing to corner of section or other legal subdivision)
being within S.W. 1/4 NW 4 of Sec. 18, Twp. 55, Rge. 1W
(Smallest legal subdivision) (N. or S.) (E. or W.)
or (b) within limits of recorded platted property, town or city:
in Lot _____, Block _____ of _____
(Name of plat or addition)

County of _____
(If within city or town, give name)

3. Construction Work was begun on Mar 1953; was completed on March 24 1953
(Date) (Date)
and the ground water claimed was first used for the purposes set out below on Mar 24 1953
(Date)
since which time the water has been used Continuously
(Continuously or intermittently)
from Mar 24 1953 to Oct 15 1957
(Date) (Date)

4. Quantity of water claimed and used is 20 gallons per minute; _____ acre feet per year.

5. Purpose or Purposes for which water is used Domestic, Irrigation

(Domestic, irrigation, municipal, manufacturing, industrial, etc.)

6. Description of Well: Depth 124.6 feet. Type Drilled
(Dug or drilled)
diameter 6 inches. Elevation of ground at well site _____ feet, mean sea level.
(As near as known)
Depth to water table _____ feet.

7. Capacity of Well: 25 g.p.m. with 21 feet drawdown. B-7 Test
_____ g.p.m. with _____ feet drawdown.


Date of test Mar - 24 1953

If Flowing Well: Measured discharge _____ g.p.m. on _____
(Date)

Shut-in pressure at ground surface _____ lbs. per sq. in. on _____
(Date)

Water is controlled by _____
(Cap, valve, etc.)

Township 5S Range 2W, W.M.
North

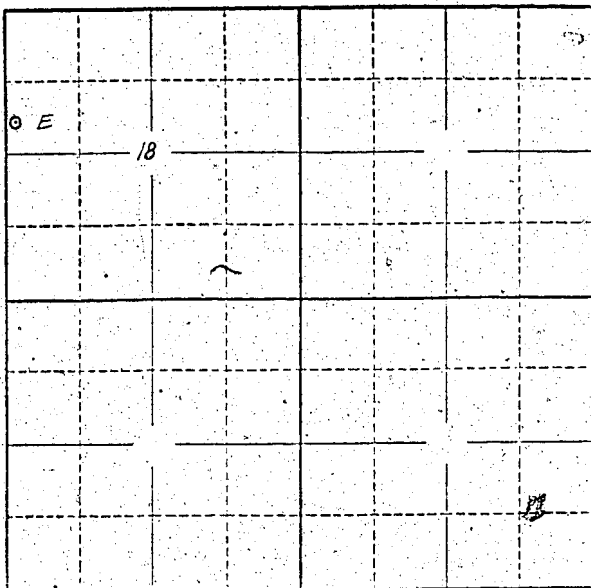

Locate well and acreage of irrigated land on plat.
Scale: 2" = 1 Mile

STATE OF OREGON

County of Marion

} ss.

I, Albert W. Marks, being first duly sworn, do hereby certify that I have read the foregoing Registration Statement and that all of the items therein contained are true to the best of my knowledge and belief.

Albert W. Marks
(Signature of Registrant)

Subscribed and sworn to before me this 28th day of July, 1958

My commission expires Sept. 8, 1960

Chris L. Wheeler
(Notary Public)

(SEAL)

CERTIFICATE OF REGISTRATION

STATE OF OREGON

County of Marion

} ss.

This is to certify that the foregoing Registration Statement was received in the office of the State Engineer on the 28th day of July, 1958, at 11:00 o'clock A. M. and has been duly recorded in said office in Book No. 11 of Registration Statements on page GR-2619

Witness my hand this 6th day of April, 1959

Walter A. [unclear]
(State Engineer)

By _____ (Deputy)

GR-2619

\$15.00