

# Registration Statement

## OF CLAIMANT OF RIGHT TO APPROPRIATE GROUND WATER

**TO THE STATE ENGINEER OF OREGON:**

I, Gilbert and Ruth Beach  
of P. O. Box 647, Corvallis County of Linn  
(Mailing address)

State of Oregon, do hereby make application for a certificate of registration as evidence of a right to appropriate ground water.

1. Source from which water is withdrawn is pump well  
(Flowing well, pump well, infiltration trench, or tunnel)
2. Location is: 4 miles East of Corvallis, Oregon  
(Approximate distance and direction from nearest city or town)

and is more particularly described as follows:

(a) 1600' N  
~~322'~~ N. and 1325' E. of SW corner S. 4, T. 12 S, R 4 W.  
(Give distance and bearing to corner of section or other legal subdivision)

being within NE 1/4 of SW 1/4 of Sec. 4, Twp. 12 S, Rge. 4 W  
(Smallest legal subdivision) (N. or S.) (E. or W.)

or (b) within limits of recorded platted property, town or city:  
in Lot \_\_\_\_\_ Block \_\_\_\_\_ of \_\_\_\_\_  
(Name of plat or addition)

County of Linn  
(If within city or town, give name)

3. Construction Work was begun on 1943 was completed on 1943  
(Date) (Date)

and the ground water claimed was first used for the purposes set out below on 1943  
(Date)

since which time the water has been used Intermittently  
(Continuously or Intermittently)

from 1943 to 1955  
(Date) (Date)

4. Quantity of water claimed and used is 225 gallons per minute; 60.0 acre feet per year.

5. Purpose or Purposes for which water is used Irrigation  
(Domestic, irrigation, municipal, manufacturing, industrial, etc.)

6. Description of Well: Depth 45 feet. Type Drilled  
(Dug or drilled)  
diameter 12 inches. Elevation of ground at well site 210 feet, mean sea level.  
(As near as known)  
Depth to water table 10 feet.

7. Capacity of Well: \_\_\_\_\_ g.p.m. with \_\_\_\_\_ feet drawdown.  
\_\_\_\_\_ g.p.m. with \_\_\_\_\_ feet drawdown.

Date of test Not tested

If Flowing Well: Measured discharge \_\_\_\_\_ g.p.m. on \_\_\_\_\_  
(Date)


Shut-in pressure at ground surface \_\_\_\_\_ lbs. per sq. in. on \_\_\_\_\_  
(Date)

Water is controlled by \_\_\_\_\_  
(Cap. valve, etc.)





Township 12 S Range 4 W, W.M.  
North

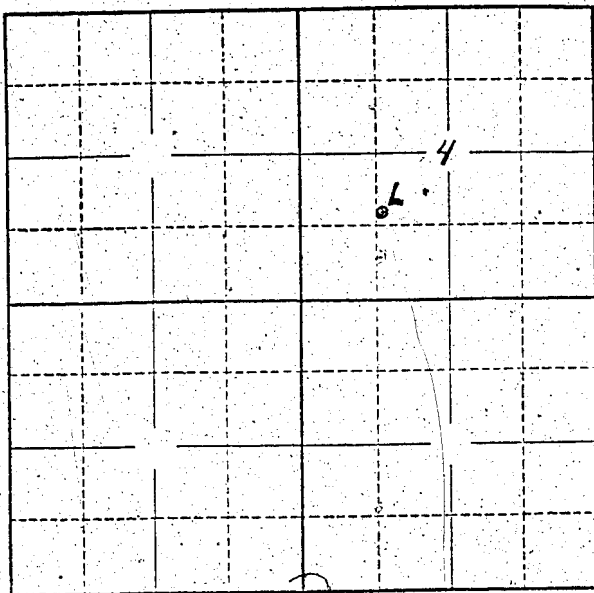

Locate well and acreage of irrigated land on plat.  
Scale: 2" = 1 Mile

STATE OF OREGON }  
County of LINN } ss.

I, Gilbert and Ruth Beach, being first duly sworn, do hereby certify that I have read the foregoing Registration Statement and that all of the items therein contained are true to the best of my knowledge and belief.

*Gilbert Beach*  
Beach Beach  
(Signature of Registrant)

Subscribed and sworn to before me this \_\_\_\_\_ day of \_\_\_\_\_, 19\_\_\_\_.

My commission expires \_\_\_\_\_

*Earl Baker*  
(Notary Public)

(SEAL)

**CERTIFICATE OF REGISTRATION**

STATE OF OREGON }  
County of Marion } ss.

This is to certify that the foregoing Registration Statement was received in the office of the State Engineer on the 27<sup>th</sup> day of July, 1952, at 2:00 o'clock P.M. and has been duly recorded in said office in Book No. // of Registration Statements on page GR-2622

Witness my hand this 6<sup>th</sup> day of April, 1959.

*Willie*  
(State Engineer)

By \_\_\_\_\_ (Deputy)

\$15.00

GR-2622