

Registration Statement

OF CLAIMANT OF RIGHT TO APPROPRIATE GROUND WATER

TO THE STATE ENGINEER OF OREGON:

I, GORDON J. OR DOROTHY E. KEEBLER

of RT. 4, BOX 598, ALBANY County of BENTON

(Mailing address)

State of OREGON do hereby make application for a certificate of registration as evidence of a right to appropriate ground water:

1. Source from which water is withdrawn is Pump Well
(Flowing well, pump well, infiltration trench, or tunnel)

2. Location is: 2 miles North of Albany, Ore.
(Approximate distance and direction from nearest city or town)

and is more particularly described as follows:

(a) S. 1/4 Sec. 32, T. 10S, R. 3W
(Give distance and bearing to corner of section, or other legal subdivision)

being within NW 1/4 S. 1/4 of Sec. 32, Twp. 10S, Rge. 3W
(Smallest legal subdivision) (N. or S.) (E. or W.)

or (b) within limits of recorded platted property, town or city:

in Lot _____, Block _____ of _____
(Name of plat or addition)

County of Benton
(If within city or town, give name)

3. Construction Work was begun on AUG 1952; was completed on AUG 1952
(Date) (Date)

and the ground water claimed was first used for the purposes set out below on AUG. 15, 1952
(Date)

since which time the water has been used CONTINUOUSLY
(Continuously or intermittently)

from AUG. 15, 1952 to PRESENT TIME
(Date) (Date)

4. Quantity of water claimed and used is 120 gallons per minute; 58.8 acre feet per year.

5. Purpose or Purposes for which water is used IRRIGATION

(Domestic, irrigation, municipal, manufacturing, industrial, etc.)

6. Description of Well: Depth 40 feet, Type DRILLED
(Dug or drilled)

diameter 10 inches. Elevation of ground at well site 212 feet, mean sea level.
(As near as known)

Depth to water table 218 feet.

7. Capacity of Well: 350 g.p.m. with 0 feet drawdown.

 g.p.m. with feet drawdown.


Date of test AUG. 1952

If Flowing Well: Measured discharge g.p.m. on (Date)

Shut-in pressure at ground surface lbs. per sq. in. on (Date)

Water is controlled by
(Cap, valve, etc.)

Township 10 S. Range 3 W., W.M.
North

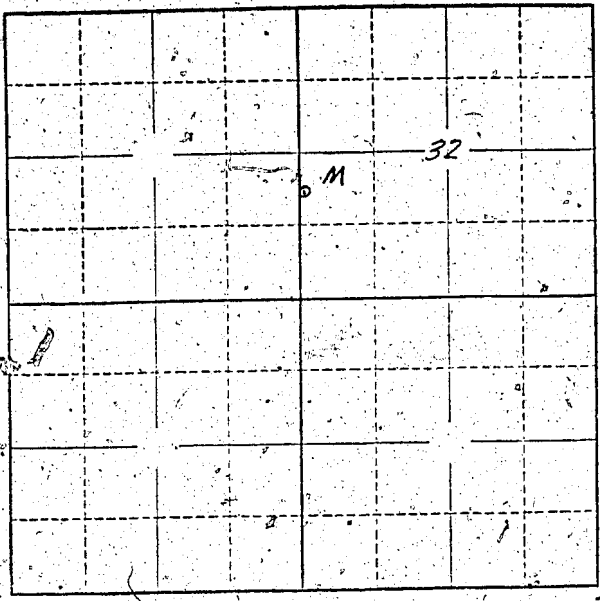

Locate well and acreage of irrigated land on plat.
Scale: 2" = 1 Mile

STATE OF OREGON
County of Linn

ss.

I, GORDON J. & DOROTHY E. KEEBLER being first duly sworn, do hereby certify that I have read the foregoing Registration Statement and that all of the items therein contained are true to the best of my knowledge and belief.

Gordon J. Keebler
(Signature of Registrant)

Subscribed and sworn to before me this 05 day of July, 1958

My commission expires 4-26-61

James H. [Signature]
(Notary Public)

(SEAL)

CERTIFICATE OF REGISTRATION

STATE OF OREGON
County of Marion

ss.

This is to certify that the foregoing Registration Statement was received in the office of the State Engineer on the 27th day of July, 1958, at 8:00 o'clock A. M. and has been duly recorded in said office in Book No. 11 of Registration Statements on page GR 2627

Witness my hand this 6th day of April, 1959

Arthur A. [Signature]
(State Engineer)

By _____
(Deputy)

\$1500

GR - 2627