Registration No. GR – 2784

Certificate No. GR 2631

Registration Statement

OF CLAIMANT OF RIGHT TO APPROPRIATE GROUND WATER

TO THE STATE ENGINEER OF OREGON:

I, Lynn Gallagher,

of Route 1, Box 437, Corvallis (Mailing address) County of Benton

State of Oregon, do hereby make application for a certificate of registration as evidence of a right to appropriate ground water.

1. **Source** from which water is withdrawn is pump well (Flowing well, pump well, infiltration trench, or tunnel)

2. **Location** is: 3 miles NE of Corvallis, Oregon (Approximate distance and direction from nearest city or town);

and is more particularly described as follows:

(a) 1200' South of N¼ Cor of intersection with S. Line of tract 9 from which point the well lies 432' East (Give distance and bearing to corner of section or other legal subdivision)

being within NW¼ NE¼ (Smallest legal subdivision) of Sec. 19, Twp. 11S (N. or S.), Rge. 4W (E. or W.)

or (b) within limits of recorded platted property, town or city:

in Lot ..., Block ... of ... (Name of plat or addition)

... (If within city or town, give name) County of ...

3. **Construction Work** was begun on May, 1940 (Date); was completed on May, 1950 (Date)

and the ground water claimed was first used for the purposes set out below on May, 1940 (Date),

since which time the water has been used continuously (Continuously or intermittently)

from 1940 (Date) to 1958 (Date)

4. **Quantity** of water claimed and used is 12 gallons per minute; 6 acre feet per year.

5. **Purpose or Purposes** for which water is used ~~domestic &~~ (exempt) irrigation

(Domestic, irrigation, municipal, manufacturing, industrial, etc.)

6. **Description of Well:** Depth 55 feet. Type drilled (Dug or drilled)

diameter 4 inches. Elevation of ground at well site 250 (As near as known) feet, mean sea level.

Depth to water table ... feet.

7. **Capacity of Well:** 15 g.p.m. with ... feet drawdown.

... g.p.m. with ... feet drawdown.

Date of test ...

If Flowing Well: Measured discharge ... g.p.m. on ... (Date)

Shut-in pressure at ground surface ... lbs. per sq. in. on ... (Date)

Water is controlled by ... (Cap, valve, etc.)

8. **Casing:** (Give diameter, commercial specifications and depth below ground surface of each casing size.)

4 inch diameter for full 45' from 0 to 45 feet

inch diameter from to feet

inch diameter from to feet

inch diameter from to feet

Describe and show depth of shoe, plug, adapter, liner or other details: A

small open bottom 2' below end of pipe

9. **Perforated Casings or Screens:**

(Number per foot and size of perforations, or describe screen) from to

from to

from to

from to

10. **Log of Well:** (Describe each stratum or formation clearly, indicate if water bearing, and give thickness and depth as indicated.)

MATERIAL	Thickness (Feet)	Depth to Bottom (Feet)
Willamette	2	
Clay	20	
Sand (pure)	2	
Clay	11	
Gravel	10	
	45	

GR 2631

If log of well is not available, give name and address of driller. C. L. Schillings

11. **Infiltration Trench:** Covered or open .....

Dimensions: Length ..... ft. Minimum depth ..... ft. Maximum depth ..... ft.

Bottom width ..... ft. Discharge ..... g.p.m. Date of test .....

12. **Tunnel:** Type of lining .....

Dimensions: .....
(Length, course, and cross sectional size)

Position of water bearing stratum with reference to portal of tunnel .....

Log of tunnel: (Preceding table for log of well may be used, if desired. Give footage from portal and character of materials, as pertinent.)

13. **Pumping Equipment:**

(a) Pump Shasta - combination ..... Capacity 15 g.p.m.
(Make, type and size)

(b) Motor 1 hp
(Type and horsepower)

14. Location of area irrigated or to be irrigated, or place of use if for purposes other than irrigation.

Township North or South	Range E. or W. of Willamette Meridian	Section	Forty-acre Tract	Number Acres To Be Irrigated	Date of Reclamation
11S	4W	19	NW¼ NE¼	1.8	1940
			NE¼ NW¼	1.3	
				3.1 Ac	
				3.1	

15. If the ground water supply is supplemental to an existing water supply, identification of any application for a permit, permit, certificate or adjudicated right to appropriate water made or held by the registrant.

.....

.....

GR 2631

Township 11S Range 4W, W.M.

North

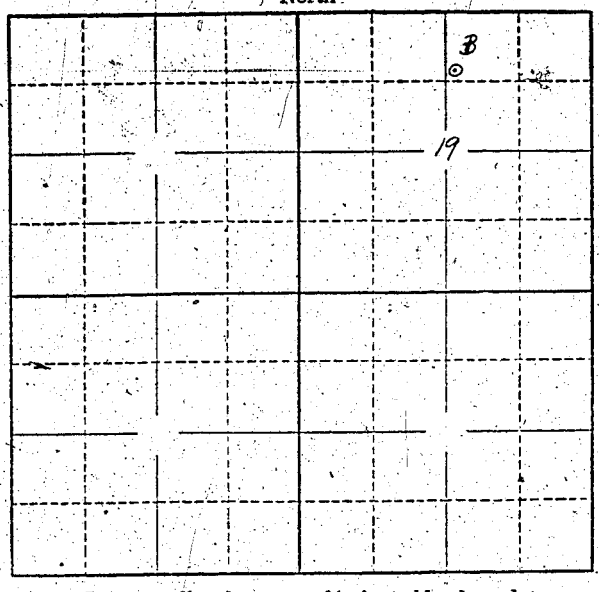

Locate well and acreage of irrigated land on plat.

Scale: 2" = 1 Mile

STATE OF OREGON
County of Lane } ss.

I, Fagan Hallagan, being first duly sworn, do hereby certify that I have read the foregoing Registration Statement and that all of the items therein contained are true to the best of my knowledge and belief.

(Signature of Registrant)

Subscribed and sworn to before me this 25 day of July, 19 55

My commission expires Notary Public for Lane County, Oregon My Commission Expires Aug. 21, 1960 (Notary Public)

(SEAL)

CERTIFICATE OF REGISTRATION

STATE OF OREGON
County of Marion } ss.

This is to certify that the foregoing Registration Statement was received in the office of the State Engineer on the 28 day of July, 19 55, at 8:00 o'clock A.M. and has been duly recorded in said office in Book No. 11 of Registration Statements on page GR-2631

Witness my hand this 6th day of April, 19 59

(State Engineer)

$15.00

By (Deputy)

GR-2631