

Registration Statement

OF CLAIMANT OF RIGHT TO APPROPRIATE GROUND WATER

TO THE STATE ENGINEER OF OREGON:

I, Earl N. Grabel

of Route 4, Box 168, Hillsboro County of Washington

State of Oregon, do hereby make application for a certificate of registration as evidence of a right to appropriate ground water.

- 1. Source from which water is withdrawn is Pumped well
(Flowing well, pump well, infiltration trench, or tunnel)
- 2. Location is: 3 miles South Hillsboro - Hwy 219
(Approximate distance and direction from nearest city or town)

and is more particularly described as follows:

(a) 60 rods East and 60' N from SW Corner NW 1/4 SW 1/4
(Give distance and bearing to corner of section or other legal subdivision)
being within N.W. 1/4 SW 1/4 of Sec. 18, Twp. 15, Rge. 2W
(Smallest legal subdivision) (N. or S.) (E. or W.)

or (b) within limits of recorded platted property, town or city:

in Lot _____, Block _____ of _____
(Name of plat or addition)

County of _____
(If within city or town, give name)

- 3. Construction Work was begun on unk; was completed on unk
(Date) (Date)

and the ground water claimed was first used for the purposes set out below on 1951
(Date)

since which time the water has been used Continuously For Domestic use
(Continuously or intermittently)
from 1 1951 to Present Date
(Date) (Date)

- 4. Quantity of water claimed and used is 20 gallons per minute; 36 acre feet per year.

- 5. Purpose or Purposes for which water is used Irrigation + Domestic
(Domestic, irrigation, municipal, manufacturing, industrial, etc.)

6. Description of Well: Depth 125 feet. Type drilled
(Dug or drilled)
diameter 6 inches. Elevation of ground at well site _____ feet, mean sea level.
(As near as known)
Depth to water table 85.25 feet.

- 7. Capacity of Well: 20 g.p.m. with 5.5 feet drawdown.
_____ g.p.m. with _____ feet drawdown.


Date of test Approx. - 1951

If Flowing Well: Measured discharge _____ g.p.m. on _____
(Date)

Shut-in pressure at ground surface _____ lbs. per sq. in. on _____
(Date)

Water is controlled by _____
(Cap, valve, etc.)

Township 15 Range 2W, W.M.
North

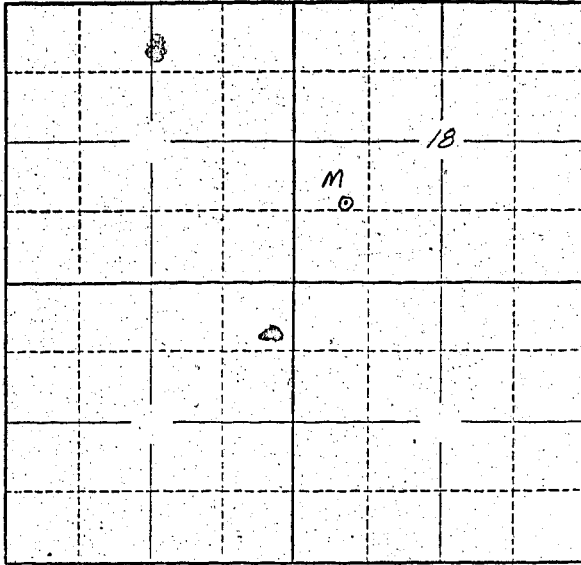

Locate well and acreage of irrigated land on plat.

Scale: 2" = 1 Mile

STATE OF OREGON

County of Washington } ss.

I, Earl M. Grabel, being first duly sworn, do hereby certify that I have read the foregoing Registration Statement and that all of the items therein contained are true to the best of my knowledge and belief.

Earl M. Grabel
(Signature of Registrant)

Subscribed and sworn to before me this 25th day of July, 1953.

My commission expires 12/17/61

(Notary Public)

(SEAL)

CERTIFICATE OF REGISTRATION

STATE OF OREGON

County of Marion } ss.

This is to certify that the foregoing Registration Statement was received in the office of the State Engineer on the 28 day of July, 1953, at 5:00 o'clock A.M. and has been duly recorded in said office in Book No. 11 of Registration Statements on page GR 2635

Witness my hand this 6th day of April, 1959

\$1500

W. W. Smith
(State Engineer)

By _____
(Deputy)

GR - 2635