

Registration Statement

OF CLAIMANT OF RIGHT TO APPROPRIATE GROUND WATER

TO THE STATE ENGINEER OF OREGON:

I, T. R. Girard

of 2115 Wheatland Rd. County of MARION
(Mailing address)

State of OREGON, do hereby make application for a certificate of registration as evidence of a right to appropriate ground water.

1. Source from which water is withdrawn is Flow Pump Well
(Flowing well, pump well, infiltration trench, or tunnel)

2. Location is: 10 miles N. Salem
(Approximate distance and direction from nearest city or town)

and is more particularly described as follows:

(a) 351F+ N. - 107F+ E. of SE CORNER of NE 1/4 of SE 1/4 of Sect. 9
(Give distance and bearing to corner of section or other legal subdivision)

being within NE 1/4 of SE 1/4 of Sec. 9, Twp. 6-S, Rge. 3-W
(Smallest legal subdivision) (N. or S.) (E. or W.)

or (b) within limits of recorded platted property, town or city:

in Lot _____, Block _____ of _____
(Name of plat or addition)

County of _____
(If within city or town, give name)

3. Construction Work was begun on June 17, 1955; was completed on June 18, 1955
(Date) (Date)

and the ground water claimed was first used for the purposes set out below on June 25, 1955
(Date)

since which time the water has been used Intermittently
(Continuously or Intermittently)

from April to Sept
(Date) (Date)

4. Quantity of water claimed and used is 600 gallons per minute; 60 acre feet per year.

5. Purpose or Purposes for which water is used IRRIGATION

(Domestic, irrigation, municipal, manufacturing, industrial, etc.)

6. Description of Well: Depth 39 feet. Type Drilled
(Dug or drilled)

diameter 12 inches. Elevation of ground at well site 170 feet, mean sea level.
(As near as known)

Depth to water table 12-14 feet.

7. Capacity of Well: 700 g.p.m. with 3 feet drawdown.

_____ g.p.m. with _____ feet drawdown.


Date of test _____

If Flowing Well: Measured discharge _____ g.p.m. on _____
(Date)

Shut-in pressure at ground surface _____ lbs. per sq. in. on _____
(Date)

Water is controlled by _____
(Cap, valve, etc.)

Township 6 S Range 3 W, W.M.
North

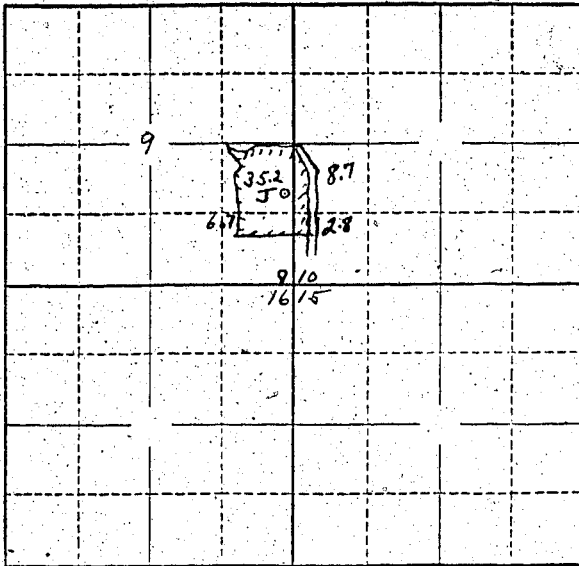

Locate well and acreage of irrigated land on plat.
Scale: 2" = 1 Mile

STATE OF OREGON

County of Marion } ss.

I, T. R. Girod, being first duly sworn, do hereby certify that I have read the foregoing Registration Statement and that all of the items therein contained are true to the best of my knowledge and belief.

T. R. Girod
.....
(Signature of Registrant)

Subscribed and sworn to before me this 16th day of July, 1958.

My commission expires 3/16/62.....
.....
(Notary Public)

(SEAL)

CERTIFICATE OF REGISTRATION

STATE OF OREGON

County of Marion } ss.

This is to certify that the foregoing Registration Statement was received in the office of the State Engineer on the 28 day of July, 1958, at 5:00 o'clock A. M. and has been duly recorded in said office in Book No. 11 of Registration Statements on page GR-2639

Witness my hand this 6th day of April, 1959.

W. W. H. Miller
.....
(State Engineer)

By
.....
(Deputy)

\$18.00

GR - 2639