

# Registration Statement

## OF CLAIMANT OF RIGHT TO APPROPRIATE GROUND WATER

(Under Chapter 708, Oregon Laws 1955.)

TO THE STATE ENGINEER OF OREGON:

I, Ernest J. Mae Farlane  
of NS Box 655 Oregon City County of Clatsop  
State of Oregon do hereby make application for a certificate of registration as evidence of a right to appropriate ground water.

1. Source from which water is withdrawn is Pump Well  
(Flowing well, pump well, infiltration trench, or tunnel)

2. Location is: Equi-distance, Brewer-Leland road, 8 miles east of Oregon City  
(Approximate distance and direction from nearest city or town)

and is more particularly described as follows:

(a) 1025 feet east & 1330 feet south from NW corner Section 30  
(Give distance and bearing to corner of section or other legal subdivision)

being within S 1/4 of N 1/4 of Sec. 30 Twp. 2 S Rge. 3 E  
(Smallest legal subdivision) (N. or S.) (E. or W.)

or (b) within limits of recorded platted property, town or city:

in Lot \_\_\_\_\_, Block \_\_\_\_\_ of \_\_\_\_\_  
(Name of plat or addition)

County of \_\_\_\_\_  
(If within city or town, give name)

3. Construction Work was begun on 9/26/49; was completed on 9/13/49  
(Date) (Date)

and the ground water claimed was first used for the purposes set out below on 9/26/49  
(Date)

since which time the water has been used Continuously  
(Continuously or intermittently)

from 9/26/49 to 7/24/58  
(Date) (Date)

4. Quantity of water claimed and used is 50 gallons per minute; \_\_\_\_\_ acre feet per year.

5. Purpose or Purposes for which water is used Irrigation

(Domestic, irrigation, municipal, manufacturing, industrial, etc.)

6. Description of Well: Depth 104 feet. Type Bored  
(Dug or drilled)

diameter 6 inches. Elevation of ground at well site 74 feet, mean sea level.  
(As near as known)

Depth to water table 30 feet.

7. Capacity of Well: 50 g.p.m. with 7 feet drawdown.

\_\_\_\_\_ g.p.m. with \_\_\_\_\_ feet drawdown.

Date of test 9/13/49

If Flowing Well: Measured discharge \_\_\_\_\_ g.p.m. on \_\_\_\_\_  
(Date)

Shut-in pressure at ground surface \_\_\_\_\_ lbs. per sq. in. on \_\_\_\_\_  
(Date)

Water is controlled by \_\_\_\_\_  
(Cap, valve, etc.)

8. Casing: (Give diameter, commercial specifications and depth below ground surface of each casing size.)

6 inch diameter from ..... to 704 feet  
..... inch diameter from ..... to ..... feet  
..... inch diameter from ..... to ..... feet  
..... inch diameter from ..... to ..... feet

Describe and show depth of shoe, plug, adapter, liner or other details: .....

9. Perforated Casings or Screens:

..... from ..... to .....  
(Number per foot and size of perforations, or describe screen)  
..... from ..... to .....  
..... from ..... to .....  
..... from ..... to .....

10. Log of Well: (Describe each stratum or formation clearly, indicate if water bearing, and give thickness and depth as indicated.)

MATERIAL	Thickness (Feet)	Depth to Bottom (Feet)
Clay	90	14
Blue med. gravel	10	4
Black sand, gravel	4	0

If log of well is not available, give name and address of driller. *A. O. Olsen*

*R 2 Bob 335 Boring Oregon*

11. Infiltration Trench: Covered or open

Dimensions: Length ..... ft. Minimum depth ..... ft. Maximum depth ..... ft.

Bottom width ..... ft. Discharge ..... g.p.m. Date of test .....

12. Tunnel: Type of lining

Dimensions: ..... (Length, course, and cross sectional size)

Position of water bearing stratum with reference to portal of tunnel .....

Log of tunnel: (Preceding table for log of well may be used, if desired. Give footage from portal and character of materials, as pertinent.)

13. Pumping Equipment:

(a) Pump *Jicuzzi Multi-stage Jet* Capacity *35* g.p.m.  
(Make, type and size)


(b) Motor *3 H.P. Federal*  
(Type and horsepower)

14. Location of area irrigated or to be irrigated, or place of use if for purposes other than irrigation.

Township North or South	Range E. or W. of Willamette Meridian	Section	Forty-acre Tract	Number Acres To Be Irrigated	Date of Reclamation
<i>T 2 S</i>	<i>R 3 E</i>	<i>30</i>	<i>SW 1/4 of NW 1/4</i>	<i>9.4</i>	<i>1949</i>

15. If the ground water supply is supplemental to an existing water supply, identification of any application for a permit, permit, certificate or adjudicated right to appropriate water made or held by the registrant.

Township 25 Range 3E, W.M.  
North

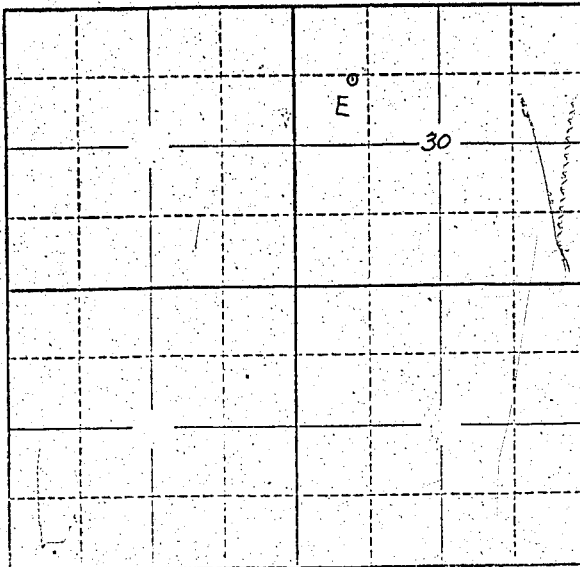

Locate well and acreage of irrigated land on plat.  
Scale: 2" = 1 Mile

STATE OF OREGON

County of Washington } ss.

I, E. Mae Jarlane, being first duly sworn, do hereby certify that I have read the foregoing Registration Statement and that all of the items therein contained are true to the best of my knowledge and belief.

E. Mae Jarlane  
(Signature of Registrant)

Subscribed and sworn to before me this 26 day of July, 1958

My Commission Expires Mar. 3, 1961

My commission expires \_\_\_\_\_  
(Notary Public)

(SEAL)

**CERTIFICATE OF REGISTRATION**

STATE OF OREGON

County of Marion } ss.

This is to certify that the foregoing Registration Statement was received in the office of the State Engineer on the 28 day of July, 1958, at 8:45 o'clock A.M. and has been duly recorded in said office in Book No. 11 of Registration Statements on page GR 2640

~~Construction shall be completed by \_\_\_\_\_ and the water completely applied to beneficial uses by \_\_\_\_\_~~

Witness my hand this 6th day of April, 1959

Henry A. Murray  
(State Engineer)

By \_\_\_\_\_ (Deputy)

GR-2640

1/500