

Registration Statement**OF CLAIMANT OF RIGHT TO APPROPRIATE GROUND WATER**

(Under Chapter 708, Oregon Laws 1955.)

TO THE STATE ENGINEER OF OREGON:I, Archie R. Eberhardt and Elsie E. Eberhardtof Silverton County of MarionState of Oregon do hereby make application for a certificate of registration as evidence of a right to appropriate ground water.1. Source from which water is withdrawn is pump well
(Flowing well, pump well, infiltration trench, or tunnel)2. Location is: 2 1/2 miles west of Silverton
(Approximate distance and direction from nearest city or town)

and is more particularly described as follows:

(a) 510 feet north and 260 feet west of southeast corner of Section 29
(Give distance and bearing to corner of section or other legal subdivision)
being within S 1/2 of E 1/2 of SE 1/4 of Sec. 29, Twp. 6S, Rge. 1W
(Smallest legal subdivision) (N. or S.) (E. or W.)

or (b) within limits of recorded platted property, town or city:

in Lot _____, Block _____ of _____
(Name of plat or addition)
County of _____
(If within city or town, give name)3. Construction Work was begun on 1947; was completed on 1947
(Date) (Date)and the ground water claimed was first used for the purposes set out below ~~on~~ prior to 1947
(1947 being the year we purchased the farm) (believe to be Spring, (Date) 1946)
since which time the water has been used continuously throughout the summer months
(Continuously or intermittently)from prior to 1947 to Sept. 1955
(Date) (Date)4. Quantity of water claimed and used is 100 gallons per minute; 30 acre
feet per year.5. Purpose or Purposes for which water is used Irrigation and domestic

(Domestic, irrigation, municipal, manufacturing, industrial, etc.)

6. Description of Well: Depth 190 feet. Type Drilled
(Dug or drilled)
diameter 8 inches. Elevation of ground at well site 249 feet, mean sea level.
(As near as known)
Depth to water table not known feet.7. Capacity of Well: g.p.m. with _____ feet drawdown.

_____, g.p.m. with _____ feet drawdown.

Date of test No official test
(Above information not stated on log furnished.)If Flowing Well: Measured discharge _____ g.p.m. on _____
(Date)Shut-in pressure at ground surface _____ lbs. per sq. in. on _____
(Date)Water is controlled by _____
(Cap, valve, etc.)

8. Casing: (Give diameter, commercial specifications and depth below ground surface of each casing size.)

8 inch diameter from 0 to 187 1/2 feet
 inch diameter from to feet
 inch diameter from to feet
 inch diameter from to feet
 (Specifications not stated on log furnished.)

Describe and show depth of shoe, plug, adapter, liner or other details: (Not stated on log furnished.)

9. Perforated Casings or Screens:

(Not stated on log furnished.) from 56 ft. to 66 ft.
(Number per foot and size of perforations, or describe screen)

..... from 66 to 77

..... from 91 to 99

..... from 221 to 128

10. Log of Well: (Describe each stratum or formation clearly, indicate if water bearing, and give thickness and depth as indicated.)

| MATERIAL | Thickness (Feet) | Depth to Bottom (Feet) |
|---|------------------|------------------------|
| Clay | 40 | 40 |
| Hard Gravel - Water at 42 feet | 20 | 60 |
| Loose Gravel - Water at 65 feet | 5 | 65 |
| Hard Gravel - Water at 80 feet | 15 | 80 |
| Loose Gravel | 10 | 90 |
| Hard Gravel | 10 | 100 |
| Loose Gravel | 10 | 110 |
| Sheet Rock | 4 | 114 |
| Loose Coarse Sand - Water at 118 feet | 4 | 118 |
| Loose Dirty Gravel | 10 | 128 |
| Dirty Sand | 19 | 147 |
| Formation not on log. - Water at 185 feet | 43 | 190 |
| | | |
| | | |
| | | |
| | | |
| | | |
| | | |
| | | |
| | | |

If log of well is not available, give name and address of driller.

11. Infiltration Trench: Covered or open

Dimensions: Length ft. Minimum depth ft. Maximum depth ft.

Bottom width ft. Discharge g.p.m. Date of test

12. Tunnel: Type of lining

Dimensions:
(Length, course, and cross sectional size)

Position of water bearing stratum with reference to portal of tunnel

Log of tunnel: (Preceding table for log of well may be used, if desired. Give footage from portal and character of materials, as pertinent.)

13. Pumping Equipment:

(a) Pump Pearlase - Turbine - 4 inch outlet Capacity 140 g.p.m.
(Make, type and size)


(b) Motor Electric - single-phase - 5 horsepower
(Type and horsepower)

14. Location of area irrigated or to be irrigated, or place of use if for purposes other than irrigation.

| Township North or South | Range E. or W. of Willamette Meridian | Section | Forty-acre Tract | Number Acres To Be Irrigated | Date of Reclamation |
|-------------------------|---------------------------------------|---------|--|------------------------------|---------------------|
| 6S | 1W | 29 | SE 1/4 of SE 1/4 S 1/2 of E 1/2 of SE 1/4 | 40 | prior to 1947 |
| | | | | | |
| | | | | | |
15. If the ground water supply is supplemental to an existing water supply, identification of any application for a permit, permit, certificate or adjudicated right to appropriate water made or held by the registrant.

Township 6 S Range 1 W, W.M.
North

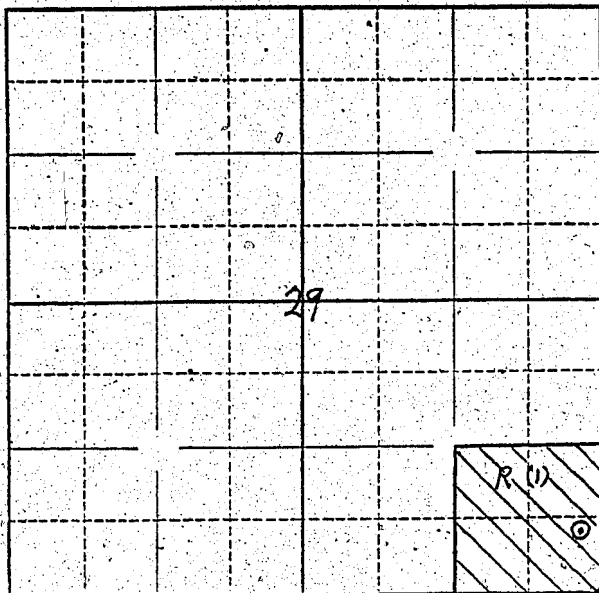

Locate well and acreage of irrigated land on plat.

Scale: $\frac{1}{4}$ " = 1 Mile

STATE OF OREGON

County of Marion

} ss.

I, Archie R. Eberhardt and Elsie E. Eberhardt, being first duly sworn, do hereby certify that I have read the foregoing Registration Statement and that all of the items therein contained are true to the best of my knowledge and belief.

Archie R. Eberhardt
Elsie E. Eberhardt
(Signature of Registrant)

Subscribed and sworn to before me this 28th day of October, 1955.

My commission expires May 17, 1958

C. B. Johnson
(Notary Public)

For State of Oregon

(SEAL)

CERTIFICATE OF REGISTRATION

STATE OF OREGON

County of Marion

} ss.

This is to certify that the foregoing Registration Statement was received in the office of the State Engineer on the 28th day of October, 1955, at 10:15 o'clock A. M. and has been duly recorded in said office in Book No. 1 of Registration Statements on page 24

Construction shall be completed by 15, 1955, and the water completely applied to beneficial use by 15, 1955.

Witness my hand this 24th day of February, 1956

Lewis A. Stanley
(State Engineer)

By

(Deputy)