

Registration Statement

OF CLAIMANT OF RIGHT TO APPROPRIATE GROUND WATER

TO THE STATE ENGINEER OF OREGON:

I, Hubert L. Wilson
of Route 1, Box 250 County of Yamhill
(Mailing address)
State of Oregon, do hereby make application for a certificate of registration as evidence of a right to appropriate ground water.

1. Source from which water is withdrawn is pump well
(Flowing well, pump well, infiltration trench, or tunnel)
2. Location is 2 1/2 miles south east of Dayton, Oregon
(Approximate distance and direction from nearest city or town)

and is more particularly described as follows:

- (a) -2385' N and 175' W of S corner
(Give distance and bearing to corner of section or other legal subdivision)
being within NE 1/4 of SW 1/4 of Sec. 27 Twp. 4 S Rge. 3 W
(Smallest legal subdivision) (N. or S.) (E. or W.)
- or (b) within limits of recorded platted property, town or city:
in Lot _____, Block _____ of _____
(Name of plat or addition)

County of _____
(If within city or town, give name)

3. Construction Work was begun on November 1, 1954; was completed on November 30, 1954
(Date) (Date)

and the ground water claimed was first used for the purposes set out below on May 1955
(Date)
since which time the water has been used continuously
(Continuously or Intermittently)

from May 1955 to July 1958
(Date) (Date)

4. Quantity of water claimed and used is 80 gallons per minute; _____ acre feet per year.

5. Purpose or Purposes for which water is used irrigation

(Domestic, irrigation, municipal, manufacturing, industrial, etc.)

6. Description of Well: Depth 135 feet. Type drilled
(Dug or drilled)
diameter 12 inches. Elevation of ground at well site 165' feet, mean sea level.
(As near as known)
Depth to water table 30 feet.

7. Capacity of Well: 80 g.p.m. with 43 feet drawdown.
_____ g.p.m. with _____ feet drawdown.

Date of test November 29, 1954

If Flowing Well: Measured discharge _____ g.p.m. on _____
(Date)

Shut-in pressure at ground surface _____ lbs. per sq. in. on _____
(Date)

Water is controlled by _____
(Cap, valve, etc.)

8. Casing: (Give diameter, commercial specifications and depth below ground surface of each casing size.)

12 inch diameter from 0 to 123 feet
 inch diameter from to feet
 inch diameter from to feet
 inch diameter from to feet

Describe and show depth of shoe, plug, adapter, liner or other details:


9. Perforated Casings or Screens:

six $\frac{1}{2}$ " X 6" perforations per foot from 55 to 116
(Number per foot and size of perforations, or describe screen)
 from to
 from to
 from to

10. Log of Well: (Describe each stratum or formation clearly, indicate if water bearing, and give thickness and depth as indicated.)

MATERIAL	Thickness (Feet)	Depth to Bottom (Feet)
Surface and clay	14	0- 14
Sandy clay	36	14- 50
Blue clay	8	50- 58
Tough clay	12	58- 72
Sandy	30	72-102
Sand and gravel with water (80 gal. per min.)	9	102-111
Blue Clay	8	111-119
Gray clay	14	119-133
Sandy	24	133-157
Sandy Streaks	78	157-235
Filled 12 in. hole with gravel to 116 ft.		

Township 4S Range 3W W.M.
North

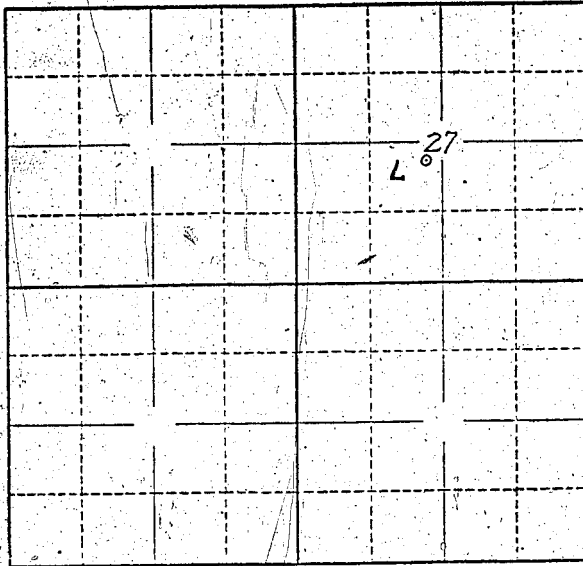

Locate well and acreage of irrigated land on plat.
Scale: 2" = 1 Mile

STATE OF OREGON

County of Gambier } ss.

I, HUBERT L. WILSON, being first duly sworn, do hereby certify that I have read the foregoing Registration Statement and that all of the items therein contained are true to the best of my knowledge and belief.

Hubert L. Wilson
(Signature of Registrant)

Subscribed and sworn to before me this 25th day of July, 1951.

My commission expires May 23, 1960 Kenneth H. Lawrence
(Notary Public)

(SEAL)

CERTIFICATE OF REGISTRATION

STATE OF OREGON

County of Marion } ss.

This is to certify that the foregoing Registration Statement was received in the office of the State Engineer on the 22nd day of July, 1951, at 8:00 o'clock A.M. and has been duly recorded in said office in Book No. 11 of Registration Statements on page GR-2643

Witness my hand this 6th day of April, 1952.

Harold A. Stoney
(State Engineer)

By _____ (Deputy)

\$15.00

GR - 2643