

Registration Statement**OF CLAIMANT OF RIGHT TO APPROPRIATE GROUND WATER**

ASSIGNED. See M.D. Rec., Vol. 4, Page 78

TO THE STATE ENGINEER OF OREGON:I, G. E. Lynchof Route 2, Scio
(Mailing address)County of LinnState of Oregon, do hereby make application for a certificate of registration as evidence of a right to appropriate ground water.1. Source from which water is withdrawn is pump well
(Flowing well, pump well, infiltration trench, or tunnel)2. Location is: 3 1/2 miles N. of Scio, Oregon
(Approximate distance and direction from nearest city or town)

and is more particularly described as follows:

(a) S. 28° 20' W. 7.5 Chains from NE corner of S. 36, T. 9S., R. 2W. WM
(Give distance and bearing to corner of section or other legal subdivision)being within NE 1/4 of NE 1/4 of Sec. 36, Twp. 9S., Rge. 2W.
(Smallest legal subdivision) (N. or S.) (E. or W.)

or (b) within limits of recorded platted property, town or city:

in Lot _____, Block _____ of _____
(Name of plat or addition)County of Linn
(If within city or town, give name)3. Construction Work was begun on April 1952; was completed on April 1952
(Date) (Date)and the ground water claimed was first used for the purposes set out below on May 1952
(Date)since which time the water has been used Continuously
(Continuously or intermittently)from May 1952 to present time
(Date) (Date)4. Quantity of water claimed and used is 90 gallons per minute; 42.5 acre feet per year.5. Purpose or Purposes for which water is used Irrigation

(Domestic, irrigation, municipal, manufacturing, industrial, etc.)

6. Description of Well: Depth 125 feet. Type Drilled
(Dug or drilled)diameter 6 inches. Elevation of ground at well site 365 feet, mean sea level.
(As near as known)Depth to water table 20 feet.7. Capacity of Well: 125 g.p.m. with 20 feet drawdown.

_____ g.p.m. with _____ feet drawdown.

Date of test _____

If Flowing Well: Measured discharge _____ g.p.m. on _____
(Date)Shut-in pressure at ground surface _____ lbs. per sq. in. on _____
(Date)Water is controlled by _____
(Cap, valve, etc.)

8. **Casing:** (Give diameter, commercial specifications and depth below ground surface of each casing size.)

6	inch diameter	steel casing	from	0	to	95	feet
	inch diameter		from		to		feet
	inch diameter		from		to		feet
	inch diameter		from		to		feet

Describe and show depth of shoe, plug, adapter, liner or other details:

9. Perforated Casings or Screens:

Slot perforations from 32' to 40'
(Number per foot and size of perforations, or describe screen)

Slot perforations from 44' to 51'

Slot perforations from 60' to 74'

Slot perforations from 74' to 92'

10. ***Log of Well:** (Describe each stratum or formation clearly, indicate if water bearing, and give thickness and depth as indicated.)

[illegible]

Shafer & Gallatly, Box 847, Philomath

11. Infiltration Trench: Covered or open

Dimensions: Length ft. Minimum depth ft. Maximum depth ft.

Bottom width ft. Discharge g.p.m. Date of test

12. Tunnel: Type of lining

Dimensions:

(Length, course, and cross sectional size)

Position of water bearing stratum with reference to portal of tunnel

Log of tunnel: (Preceding table for log of well may be used, if desired. Give footage from portal and character of materials, as pertinent.)

13. Pumping Equipment:

(a) Pump Fairbanks Morse turbine Capacity 70 g.p.m.

(Make, type and size):

(b) Motor 5 H.P. electric


(Type and horsepower)

14. Location of area irrigated or to be irrigated, or place of use if for purposes other than irrigation.

[illegible]

15. If the ground water supply is supplemental to an existing water supply, identification of any application for a permit, permit, certificate or adjudicated right to appropriate water made or held by the registrant.

Township 9 S. Range 2 W., W.M. North

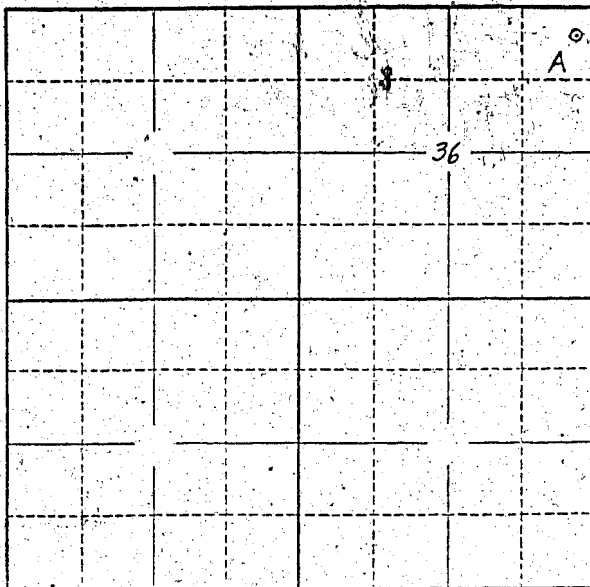

Locate well and acreage of irrigated land on plat.

Scale: 2" = 1 Mile

STATE OF OREGON

County of Linn

ss.

I, G. E. Lynch, being first duly sworn, do hereby certify that I have read the foregoing Registration Statement and that all of the items therein contained are true to the best of my knowledge and belief.

(Signature of Registrant)

Subscribed and sworn to before me this _____ day of _____, 19____.

My commission expires MY COMMISSION EXPIRES MAY 22, 1962

(Notary Public)

(SEAL)

CERTIFICATE OF REGISTRATION

STATE OF OREGON

County of Marion

ss.

This is to certify that the foregoing Registration Statement was received in the office of the State Engineer on the 22nd day of July, 1956, at 2:00 o'clock A.M. and has been duly recorded in said office in Book No. 11 of Registration Statements on page GR-2647

Witness my hand this 6th day of April, 1959

(State Engineer)

By _____

(Deputy)

GR-2647