REGISTRATION NO. GR-281

CERTIFICATE NO. GR-257

Registration Statement

OF CLAIMANT OF RIGHT TO APPROPRIATE GROUND WATER

(Under Chapter 708, Oregon Laws 1955.)

TO THE STATE ENGINEER OF OREGON:

I, D. H. Morris and Zerma L. Morris

of Rt. 2, Box 141 A, Lebanon County of Linn

State of Oregon, do hereby make application for a certificate of registration as evidence of a right to appropriate ground water.

1. **Source** from which water is withdrawn is pump well (Flowing well, pump well, infiltration trench, or tunnel)

2. **Location is:** 2 miles North of Lebanon, Oregon (Approximate distance and direction from nearest city or town);

and is more particularly described as follows:

(a) N. 55° 03' E. 41.88 chains from the SW corner of Andrew Kees DLC 71 (Give distance and bearing to corner of section or other legal subdivision)

being within SE¼ of SW¼ (Smallest legal subdivision) of Sec. 35, Twp. 11 S (N. or S.), Rge. 2 W (E. or W.)

or (b) within limits of recorded platted property, town or city:

in Lot ..... Block ..... of ..... (Name of plat or addition)

..... (If within city or town, give name) County of Linn

3. **Construction Work** was begun on Sept. 1, 1951 (Date); was completed on Sept. 6, 1951 (Date)

and the ground water claimed was first used for the purposes set out below on Sept. 15, 1951 (Date)

since which time the water has been used continuously (Continuously or intermittently)

from Sept. 15, 1951 (Date) to present time (Date)

4. **Quantity** of water claimed and used is 100 gallons per minute; 27.5 acre feet per year.

5. **Purpose or Purposes** for which water is used Irrigation

..... (Domestic, irrigation, municipal, manufacturing, industrial, etc.)

6. **Description of Well:** Depth 45 feet. Type drilled (Dug or drilled)

diameter 8 inches. Elevation of ground at well site 325 (As near as known) feet, mean sea level.

Depth to water table 15 feet.

7. **Capacity of Well:** 200 g.p.m. with 5 feet drawdown.

..... g.p.m. with ..... feet drawdown.

Date of test Not tested

If Flowing Well: Measured discharge ..... g.p.m. on ..... (Date)

Shut-in pressure at ground surface ..... lbs. per sq. in. on ..... (Date)

Water is controlled by ..... (Cap, valve, etc.)

8. **Casing:** (Give diameter, commercial specifications and depth below ground surface of each casing size.)

8 inch diameter steel casing from 0 to 45 feet

inch diameter from to feet

inch diameter from to feet

inch diameter from to feet

Describe and show depth of shoe, plug, adapter, liner or other details:

9. **Perforated Casings or Screens:**

Slit perforations from 30 to 45
(Number per foot and size of perforations, or describe screen)

from to

from to

from to

10. **Log of Well:** (Describe each stratum or formation clearly, indicate if water bearing, and give thickness and depth as indicated.)

MATERIAL	Thickness (Feet)	Depth to Bottom (Feet)
Not available		

GR-257 A

If log of well is not available, give name and address of driller. Nicholas Klaus, Rt. 4, Albany, Oregon

11. **Infiltration Trench:** Covered or open .....

Dimensions: Length ..... ft. Minimum depth ..... ft. Maximum depth ..... ft.

Bottom width ..... ft. Discharge ..... g.p.m. Date of test .....

12. **Tunnel:** Type of lining .....

Dimensions: .....
(Length, course, and cross sectional size)

Position of water bearing stratum with reference to portal of tunnel .....

Log of tunnel: (Preceding table for log of well may be used, if desired. Give footage from portal and character of materials, as pertinent.)

13. **Pumping Equipment:**

(a) Pump Gould 3" centrifugal (Make, type and size) Capacity 125 g.p.m.

(b) Motor 5 H. P. electric (Type and horsepower)

14. Location of area irrigated or to be irrigated, or place of use if for purposes other than irrigation.

Township North or South	Range E. or W. of Willamette Meridian	Section	Forty-acre Tract	Number Acres To Be Irrigated	Date of Reclamation
11 S	2 W	35	NE¼ of SW¼	0.6	Sept. 15, 1951
11 S	2 W	35	SE¼ of SW¼	6.0	"
11 S	2 W	35	SW¼ of SE¼	4.1	"
11 S	2 W	35	NW¼ of SE¼	0.3	"
				11.0	

Beginning S. 89°51' E. 1980 feet and N. 0°12' E. 2013 feet from the Southwest corner of the Andrew Kees DLC #71, T. 12 S., R. 2 W. of the Will. Mer. in Linn County, Oregon; thence S. 89°51' E. 563 feet; thence S. 0°12' W. 1056 feet; thence N. 89°51' W. 196 [illegible]; thence N. 0°12' E. 314.37 feet; thence N. 89°51' W. 367 feet; thence N. 0° [illegible] E. 741.63 feet to the place of beginning containing 11 acres, more or less.

15. If the ground water supply is supplemental to an existing water supply, identification of any application for a permit, permit, certificate or adjudicated right to appropriate water made or held by the registrant.

GR-2578

Township 11 S Range 2 W, W.M.

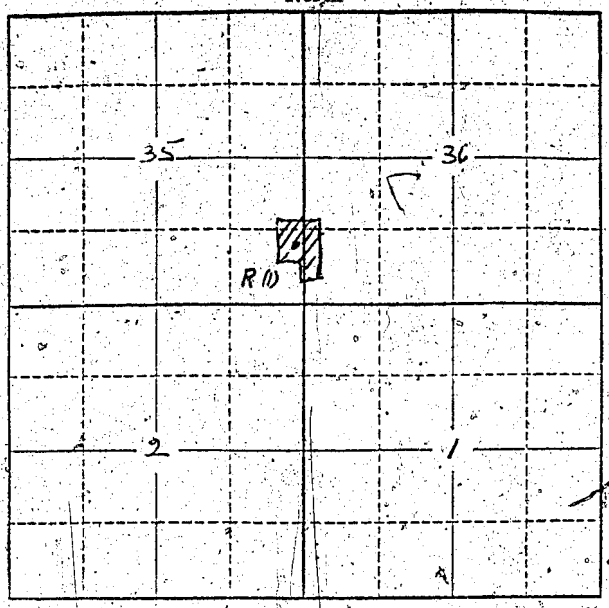

Locate well and acreage of irrigated land on plat.

Scale: 2" = 1 Mile

STATE OF OREGON
County of Linn } ss.

I, D. H. Morris and Zerma L. Morris, being first duly sworn, do hereby certify that I have read the foregoing Registration Statement and that all of the items therein contained are true to the best of my knowledge and belief.

~~Date~~ D. H. Morris
Zerma L. Morris
(Signature of Registrant)

Subscribed and sworn to before me this 23 day of October, 1956

My commission expires November 27, 1959 Harvey A. Wright
(Notary Public) for Oregon

(SEAL)

CERTIFICATE OF REGISTRATION

STATE OF OREGON
County of Marion } ss.

This is to certify that the foregoing Registration Statement was received in the office of the State Engineer on the 26th day of October, 1956, at 11 o'clock A.M. and has been duly recorded in said office in Book No. 2 of Registration Statements on page GR-257-C.

~~Certificate to be completed by the water right applicant to the extent by the State Engineer.~~

Witness my hand this 15th day of January, 1957.

Lewis A. Stanley
(State Engineer)

By
(Deputy)

GR-257-C