

RECEIVED
JUL 28 1958

Registration Statement

STATE ENGINEER

SALEM, OREGON OF CLAIMANT OF RIGHT TO APPROPRIATE GROUND WATER

TO THE STATE ENGINEER OF OREGON:

I, J. Donald Kroeker

of 4504 S. W. Corbett County of Multnomah
(Mailing address)

State of Oregon do hereby make application for a certificate of registration as evidence of a right to appropriate ground water.

1. Source from which water is withdrawn is pump well
(Flowing well, pump well, infiltration trench, or tunnel)

2. Location is: _____
(Approximate distance and direction from nearest city or town)

and is more particularly described as follows:

(a) APPROX - 1500 feet east of 100 feet north from SW corner Section 10
(Give distance and bearing to corner of section or other legal subdivision)

being within SE 1/4 of SW 1/4 of Sec. 10, Twp. 15, Rge. 1E
(Smallest legal subdivision) (N. or S.) (E. or W.)

or (b) within limits of recorded platted property, town or city: Portland

Sub Lot A
in Lot of Lot 4, Block 3 of Portland Homestead
(Name of plat or addition)

Portland County of Multnomah
(If within city or town, give name)

3. Construction Work was begun on February, 1954; was completed on April, 1954
(Date) (Date)

and the ground water claimed was first used for the purposes set out below on April, 1954
(Date)

since which time the water has been used continuously
(Continuously or intermittently)

from April, 1954 to July, 1958.
(Date) (Date)

4. Quantity of water claimed and used is used 45; claimed 90 gallons per minute; _____ acre feet per year. Well tested to produce 90 gpm. Future building on the same property will be served by the same well as a heat source and heat sink for a heat pump type air conditioning

5. Purpose or Purposes for which water is used system

Air Conditioning
(Domestic, irrigation, municipal, manufacturing, industrial, etc.)

6. Description of Well: Depth 486 feet. Type Drilled
(Dug or drilled)

diameter 8 inches. Elevation of ground at well site 210 feet, mean sea level.
(As near as known)

Depth to water table 53 feet.

7. Capacity of Well: 45 g.p.m. with 37 feet drawdown.

90 g.p.m. with 80 feet drawdown.

Date of test April, 1954

If Flowing Well: Measured discharge _____ g.p.m. on _____
(Date)

Shut-in pressure at ground surface _____ lbs. per sq. in. on _____
(Date)

Water is controlled by _____
(Cap, valve, etc.)

8. Casing: (Give diameter, commercial specifications and depth below ground surface of each casing size.)

8 inch diameter from surface to 99 feet
 inch diameter from to feet
 inch diameter from to feet
 inch diameter from to feet

Describe and show depth of shoe, plug, adapter, liner or other details:

9. Perforated Casings or Screens:

None from to
 (Number per foot and size of perforations, or describe screen)
 from to
 from to
 from to

10. Log of Well: (Describe each stratum or formation clearly, indicate if water bearing, and give thickness and depth as indicated.)

From	To	MATERIAL	Thickness (Feet)	Depth to Bottom (Feet)
Basement	40	Clay, silt, sand - surface water		
40	54	Soft brown rock with clay in seams - some water		
54	78	Grey rock		
78	81	Rock with clay in seams		
81	145	Dark grey rock, medium hard		
145	168	Hard dark blue shale, did not cave during drilling of well. Water encountered at bottom of stratum-water stood at 16 feet from top of well.		
168	243	Dark grey rock		
243	265	Soft brown rock		
265	383	Grey rock - medium hard		
383	387	Brown rock, very soft		
387	420	Brown rock, medium hard		
420	462	Dark grey rock, hard		
462	471	Caving grey water bearing rock		
471	486	Hard grey basalt rock		

If log of well is not available, give name and address of driller.

11. Infiltration Trench: Covered or open

Dimensions: Length ft. Minimum depth ft. Maximum depth ft.

Bottom width ft. Discharge g.p.m. Date of test

12. Tunnel: Type of lining

Dimensions: (Length, course, and cross sectional size)

Position of water bearing stratum with reference to portal of tunnel

Log of tunnel: (Preceding table for log of well may be used, if desired. Give footage from portal and character of materials, as pertinent.)

13. Pumping Equipment:

(a) Pump Pacific Type DFS Submersible - 4 inches Capacity 50 g.p.m.
(Make, type and size)


(b) Motor Special submersible motor, 3 hp
(Type and horsepower)

14. Location of area irrigated or to be irrigated, or place of use if for purposes other than irrigation.

Township North or South	Range E. or W. of Willamette Meridian	Section	Forty-acre Tract	Number Acres To Be Irrigated	Date of Reclamation
T15	R1E	10	SE 1/4 of SW 1/4	Industrial uses	1954

15. If the ground water supply is supplemental to an existing water supply, identification of any application for a permit, permit, certificate or adjudicated right to appropriate water made or held by the registrant.

Township 13 Range 1E, W.M.
North

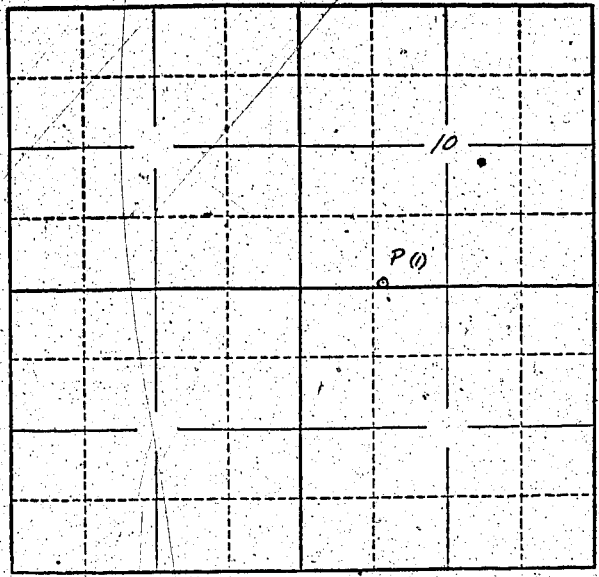

Locate well and acreage of irrigated land on plat.
Scale: 2" = 1 Mile

STATE OF OREGON }

I, Armed Kueker, being first duly sworn, do hereby certify that I have read the foregoing Registration Statement and that all of the items therein contained are true to the best of my knowledge and belief.

Armed Kueker
(Signature of Registrant)

Subscribed and sworn to before me this 15th day of July, 1958.

My commission expires Jan 1, 1960

Henry Bauer
(Notary Public)

(SEAL)

CERTIFICATE OF REGISTRATION

STATE OF OREGON }
County of Marion } ss.

This is to certify that the foregoing Registration Statement was received in the office of the State Engineer on the 29th day of July, 1958, at 8:00 o'clock A. M. and has been duly recorded in said office in Book No: 9 of Registration Statements on page GR 1919

Witness my hand this 9th day of February, 1959.

Lewis A. Stanley
(State Engineer)

By _____
(Deputy)

\$ 20.00

GR 1919