

RECEIVED  
JUL 28 1953  
STATE ENGINEER  
DEPT. OF GEOLOGY

Registration No. GR - 2811  
Certificate No. GR - 2652

# Registration Statement

## OF CLAIMANT OF RIGHT TO APPROPRIATE GROUND WATER

TO THE STATE ENGINEER OF OREGON:

I, John W. Beard  
of 3622 TABLE ROCK ROAD MADEIRA County of JACKSON  
State of OREGON, do hereby make application for a certificate of registration as evidence  
of a right to appropriate ground water.

1. Source from which water is withdrawn is PUMP WELL  
(Flowing well, pump well, infiltration trench, or tunnel)
2. Location is: 2 Miles North of Medford, Oregon  
(Approximate distance and direction from nearest city or town)

and is more particularly described as follows:

(a) 125' N 4 3/4' W FROM THE EAST S.E. COR. OF PLAT 58  
(Give distance and bearing to corner of section or other legal subdivision)  
being within S.W. 1/4 NE 1/4 of Sec. 12 Twp. 37 Rge. 2E  
(Smallest legal subdivision) (N. or S.) (E. or W.)

or (b) within limits of recorded platted property, town or city:  
in Lot \_\_\_\_\_, Block \_\_\_\_\_ of \_\_\_\_\_  
(Name of plat or addition)  
County of \_\_\_\_\_  
(If within city or town, give name)

3. Construction Work was begun on 1944; was completed on 1944  
(Date) (Date)  
and the ground water claimed was first used for the purposes set out below on 1944  
(Date)  
since which time the water has been used CONTINUOUSLY  
(Continuously or intermittently)  
from 1944 to PRESENT  
(Date) (Date)

4. Quantity of water claimed and used is 3.5 gallons per minute; 9.8 acre feet per year.

5. Purpose or Purposes for which water is used IRRIGATION  
(Domestic, irrigation, municipal, manufacturing, industrial, etc.)

6. Description of Well: Depth 12 feet; Type DUG  
(Dug or drilled)  
diameter 48 inches. Elevation of ground at well site 1280 feet, mean sea level.  
(As near as known)  
Depth to water table 20 feet.

7. Capacity of Well: 3.5 g.p.m. with 5 feet drawdown.  
\_\_\_\_\_ g.p.m. with \_\_\_\_\_ feet drawdown.  
Date of test NOTE FROM CASE

If Flowing Well: Measured discharge \_\_\_\_\_ g.p.m. on \_\_\_\_\_ (Date)


Shut-in pressure at ground surface \_\_\_\_\_ lbs. per sq. in. on \_\_\_\_\_ (Date)

Water is controlled by \_\_\_\_\_ (Cap, valve, etc.)





Township 37 S Range 2 W, W.M.  
North

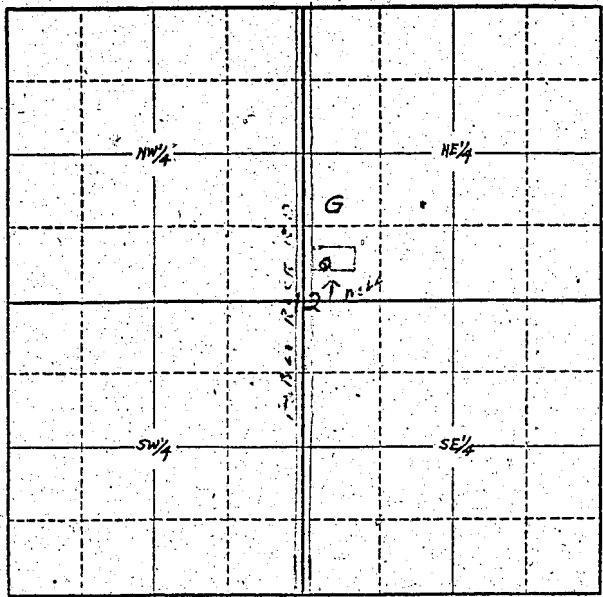

Locate well and acreage of irrigated land on plat.  
Scale: 4" = 1 Mile

STATE OF OREGON }  
County of Jackson } ss.

I, John W. Beacham, being first duly sworn, do hereby certify that I have read the foregoing Registration Statement and that all of the items therein contained are true to the best of my knowledge and belief.

.....  
(Signature of Registrant)

Subscribed and sworn to before me this 25th day of July, 1958

My commission expires August 25, 1958 / .....  
(Notary Public)

(SEAL)

**CERTIFICATE OF REGISTRATION**

STATE OF OREGON }  
County of Marion } ss.

This is to certify that the foregoing Registration Statement was received in the office of the State Engineer on the 22th day of July, 1958, at 6:00 o'clock A.M. and has been duly recorded in said office in Book No. 11 of Registration Statements on page GR-2652

Witness my hand this 6th day of April, 1959

.....  
(State Engineer)

By .....  
(Deputy)

\$1500