

# Registration Statement

## OF CLAIMANT OF RIGHT TO APPROPRIATE GROUND WATER

TO THE STATE ENGINEER OF OREGON:

I, Neal R. Thompson

of Campy Ore Route #1 Box 294

(Mailing address)

County of Clatsop

State of Oregon

do hereby make application for a certificate of registration as evidence of a right to appropriate ground water.

1. Source from which water is withdrawn is Pump Well

(Flowing well, pump well, infiltration trench, or tunnel)

2. Location is: South East of Campy on Munford Rd

(Approximate distance and direction from nearest city or town)

and is more particularly described as follows:

(a) 580 Ft. East of Section Corner & 36 feet South from W 1/4 corner Section 3.

(Give distance and bearing to corner of section or other legal subdivision)

being within NW 1/4 of SW 1/4

(Smallest legal subdivision)

of Sec. 3

Twp. 1 S

(N. or S.)

Rge. R1E

(E. or W.)

or (b) within limits of recorded platted property, town or city: no

in Lot \_\_\_\_\_, Block \_\_\_\_\_ of \_\_\_\_\_

(Name of plat or addition)

County of \_\_\_\_\_

(If within city or town, give name)

3. Construction Work was begun on May 1947

(Date)

; was completed on June 1947

(Date)

and the ground water claimed was first used for the purposes set out below on June 2, 1947

(Date)

since which time the water has been used continuously to irrigate

(Continuously or intermittently)

from June 2, 1947 to Oct 1957

(Date)

(Date)

4. Quantity of water claimed and used is 500 gallons per minute; 3 acre feet per year.

5. Purpose or Purposes for which water is used irrigation + (domestic purposes)

(Domestic, irrigation, municipal, manufacturing, industrial, etc.)

6. Description of Well: Depth 216 feet. Type Drilled

(Dug or drilled)

diameter 8 inches. Elevation of ground at well site 775

(As near as known)

feet, mean sea level. Depth to water table 55 feet. from top of casing

7. Capacity of Well: over 600 g.p.m. with 180 feet drawdown.

500 g.p.m. with 170 feet drawdown.

Date of test June 1947

If Flowing Well: Measured discharge \_\_\_\_\_ g.p.m. on \_\_\_\_\_

(Date)

Shut-in pressure at ground surface \_\_\_\_\_ lbs. per sq. in. on \_\_\_\_\_

(Date)


Water is controlled by \_\_\_\_\_

(Cap, valve, etc.)





Township 4S Range R1E, W.M.  
North

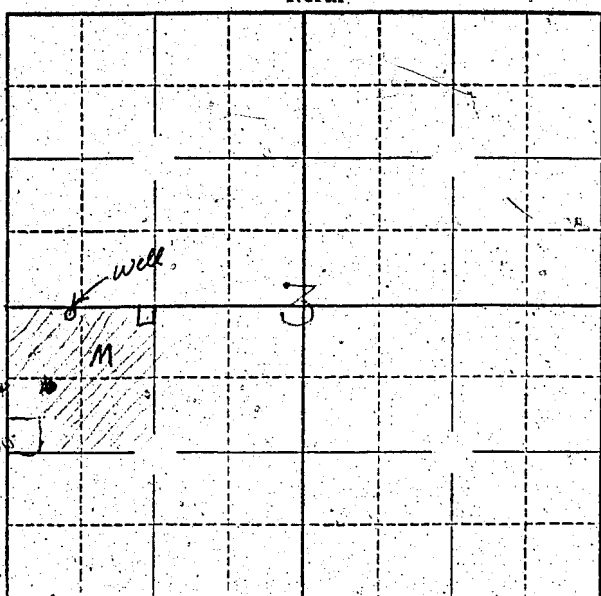

Well is 580'  
E. From section marker  
46 on my property from  
center of Road

Locate well and acreage of irrigated land on plat.  
Scale: 2" = 1 Mile

STATE OF OREGON }  
County of Clatsop } ss.

I, John P. Thompson, being first duly sworn, do hereby certify that I have read the foregoing Registration Statement and that all of the items therein contained are true to the best of my knowledge and belief.

John P. Thompson  
(Signature of Registrant)

Subscribed and sworn to before me this 28th day of July, 1958

My commission expires 12th June 1961 Wm. S. Bartholomew  
(Notary Public)

(SEAL)

**CERTIFICATE OF REGISTRATION**

STATE OF OREGON }  
County of Marion } ss.

This is to certify that the foregoing Registration Statement was received in the office of the State Engineer on the 28th day of July, 1958 at 11:30 o'clock A.M. and has been duly recorded in said office in Book No. 11 of Registration Statements on page GR-2656

Witness my hand this 6th day of April, 1959

Lewis W. Stanley  
(State Engineer)

\$ 27.90

By \_\_\_\_\_  
(Deputy)