

RECEIVED
JUL 28 1958
STATE ENGINEER

Registration No. GR. 2817

Certificate No. GR. 2658

Registration Statement

SALEM, OREGON OF CLAIMANT OF RIGHT TO APPROPRIATE GROUND WATER

TO THE STATE ENGINEER OF OREGON:

I, James R. Halvinger
of Rt #4 Box 130 Eugene County of Lane
(Mailing address)

State of Oregon, do hereby make application for a certificate of registration as evidence of a right to appropriate ground water.

1. Source from which water is withdrawn is well
(Flowing well, pump well, infiltration trench, or tunnel)

2. Location is: 6 mi. S.E. of Eugene
(Approximate distance and direction from nearest city or town)

and is more particularly described as follows: 1550 North & 300 feet west from SE corner Section 13.

(a) 200 Y. MATR. 490 FT. N.W. C.F. 67-777-4-1-2 PLOT
(Give distance and bearing to corner of section or other legal subdivision)

being within NE 1/4 SE 4 of Sec. 13, Twp. 18 S, Rge. 3 W. W. 12
(Smallest legal subdivision) (N. or S.) (E. or W.)

or (b) within limits of recorded platted property, town or city:

in Lot _____, Block _____ of _____
(Name of plat or addition)

County of _____
(If within city or town, give name)

3. Construction Work was begun on 1948; was completed on 1948
(Date) (Date)

and the ground water claimed was first used for the purposes set out below on 1948
(Date)

since which time the water has been used INTERMITTENTLY
(Continuously or intermittently)

from MAY to OCTOBER
(Date) (Date)

4. Quantity of water claimed and used is 80 gallons per minute; 2.63 acre feet per year.

5. Purpose or Purposes for which water is used IRRIGATION

(Domestic, irrigation, municipal, manufacturing, industrial, etc.)

6. Description of Well: Depth: 18 feet. Type DRILLED
(Dug or drilled)

diameter 2 inches. Elevation of ground at well site 450 feet, mean sea level.
(As near as known)

Depth to water table 8 feet.

7. Capacity of Well: Not known g.p.m. with Not known feet drawdown.

_____ g.p.m. with _____ feet drawdown.

Date of test 1948

If Flowing Well: Measured discharge _____ g.p.m. on _____
(Date)

Shut-in pressure at ground surface _____ lbs. per sq. in. on _____
(Date)

Water is controlled by _____
(Cap, valve, etc.)

8. **Casing:** (Give diameter, commercial specifications and depth below ground surface of each casing size.)

2 inch diameter pipe from to feet
 inch diameter from to feet
 inch diameter from to feet
 inch diameter from to feet

Describe and show depth of shoe, plug, adapter, liner or other details:

9. **Perforated Casings or Screens:**

5" perforated 3 ft Perforated pipe at Bottom from to
(Number per foot and size of perforations, or describe screen)
 from to
 from to
 from to

10. **Log of Well:** (Describe each stratum or formation clearly, indicate if water bearing, and give thickness and depth as indicated.)

MATERIAL	Thickness (Feet)	Depth to Bottom (Feet)
8 ft Sand Then Strike Gravel		

If log of well is not available, give name and address of driller.

11. Infiltration Trench: Covered or open

Dimensions: Length ft. Minimum depth ft. Maximum depth ft.

Bottom width ft. Discharge g.p.m. Date of test

12. Tunnel: Type of lining

Dimensions:
(Length, course, and cross sectional size)

Position of water bearing stratum with reference to portal of tunnel

Log of tunnel: (Preceding table for log of well may be used, if desired. Give footage from portal and character of materials, as pertinent.)

13. Pumping Equipment:

(a) Pump *Deming 3" outlet, 1/2" outlet* Capacity *200-250* g.p.m.
(Make, type and size)

(b) Motor *5 HP Wagner*
(Type and horsepower)


14. Location of area irrigated or to be irrigated, or place of use if for purposes other than irrigation.

Township North or South	Range E. or W. of Willamette Meridian	Section	Forty-acre Tract	Number Acres To Be Irrigated	Date of Reclamation
<i>18S</i>	<i>7WMM</i>	<i>13</i>	<i>N E 1/4 SE 4</i>	<i>10</i>	<i>1948</i>

15. If the ground water supply is supplemental to an existing water supply, identification of any application for a permit, permit, certificate or adjudicated right to appropriate water made or held by the registrant.

None

Township 18.5 Range 3 W.W.M., W.M.
North

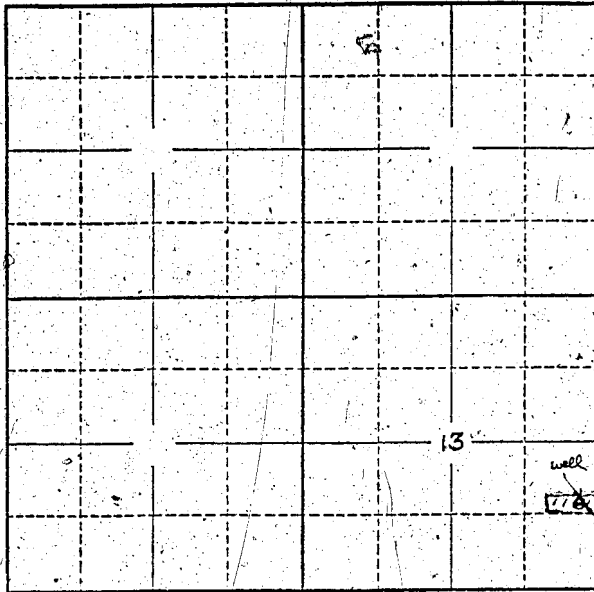

Locate well and acreage of irrigated land on plat.

Scale: 2" = 1 Mile

STATE OF OREGON

County of Lane } ss.

I, James K. Holsinger, being first duly sworn, do hereby certify that I have read the foregoing Registration Statement and that all of the items therein contained are true to the best of my knowledge and belief.

James K. Holsinger
(Signature of Registrant)

Subscribed and sworn to before me this 25th day of July, 1958.

My commission expires August 21, 1959

[Signature]
(Notary Public) for Oregon

(SEAL)

CERTIFICATE OF REGISTRATION

STATE OF OREGON

County of Marion } ss.

This is to certify that the foregoing Registration Statement was received in the office of the State Engineer on the 25th day of July, 1958, at 8:00 o'clock A.M. and has been duly recorded in said office in Book No. 11 of Registration Statements on page GR-2658

Witness my hand this 6th day of April, 1959

[Signature]
(State Engineer)

By _____ (Deputy)

GR-2658

\$15.00