

Registration Statement

OF CLAIMANT OF RIGHT TO APPROPRIATE GROUND WATER

TO THE STATE ENGINEER OF OREGON:

I, V.E. + Ruth Preedy
of Rt. 1 Box 963 Gresham Oregon County of Multnomah
(Mailing address)
State of Oregon do hereby make application for a certificate of registration as evidence
of a right to appropriate ground water.

1. Source from which water is withdrawn is Pump Well
(Flowing well, pump well, infiltration trench, or tunnel)

2. Location is: 1/2 mile NE. from Gresham Drop
(Approximate distance and direction from nearest city or town)

and is more particularly described as follows:

(a) N 73° 15' W from SE cor. Sec. 3 3170'
(Give distance and bearing to corner of section or other legal subdivision)

being within SE 1/4 SW 1/4; SW 1/4 SE 1/4 of Sec. 3, Twp. 1 S, Rge. 3 E
(Smallest legal subdivision) (N. or S.) (E. or W.)

or (b) within limits of recorded platted property, town or city:

in Lot _____, Block _____ of _____
(Name of plat or addition)

(If within city or town, give name)

County of _____

3. Construction Work was begun on Aug 15, 1945; was completed on 15 Aug 1945
(Date) (Date)

and the ground water claimed was first used for the purposes set out below on 22 Aug 1945
(Date)

since which time the water has been used intermittently
(Continuously or intermittently)

from 22 Aug 1945 to 25 July 1945
(Date) (Date)

4. Quantity of water claimed and used is 130 gallons per minute; 30 acre
feet per year. 20

5. Purpose or Purposes for which water is used Irrigation

(Domestic, irrigation, municipal, manufacturing, industrial, etc.)

6. Description of Well: Depth 23 feet. Type Dug
(Dug or drilled)
diameter 28" casing put in + Dug well re-filled
inches. Elevation of ground at well site 300 feet, mean sea level.
(As near as known)
Depth to water table 15 feet.

7. Capacity of Well: 130 g.p.m. with 4 feet drawdown.

g.p.m. with _____ feet drawdown.

Date of test 16 or 17 of Aug 1945

If Flowing Well: Measured discharge _____ g.p.m. on _____
(Date)

Shut-in pressure at ground surface _____ lbs. per sq. in. on _____
(Date)

Water is controlled by _____
(Cap, valve, etc.)

8. **Casing:** (Give diameter, commercial specifications and depth below ground surface of each casing size.)

28 inch diameter Concrete Casing starts 2 ft from surface. 24 ft to 23 feet

inch diameter from to feet

inch diameter from to feet

inch diameter from to feet

Describe and show depth of shoe, plug, adapter, liner or other details:

9. Perforated Casings or Screens:

2" perforations bottom 6 feet from 17' to 23'

(Number per foot and size of perforations, or describe screen)

from to

from to

from to

from to

10. **Log of Well:** (Describe each stratum or formation clearly, indicate if water bearing, and give thickness and depth as indicated.)

[illegible]

If log of well is not available, give name and address of driller. _____

11. Infiltration Trench: Covered or open

Dimensions: Length ft. Minimum depth ft. Maximum depth ft.

Bottom width ft. Discharge g.p.m. Date of test

12. Tunnel: Type of lining

Dimensions: _____
(Length, course, and cross sectional size)

Position of water bearing stratum with reference to portal of tunnel

Log of tunnel: (Preceding table for log of well may be used, if desired. Give footage from portal and character of materials, as pertinent.)

- ### 13. Pumping Equipment:

(a) Pump Centrifugal 1 1/2" outlet Capacity 138 g.p.m.
(Make, type and size)


(b) Motor 3 Horse - Electric
(Type and horsepower)

14. Location of area irrigated or to be irrigated, or place of use if for purposes other than irrigation.

[illegible]

15. If the ground water supply is supplemental to an existing water supply, identification of any application for a permit, permit, certificate or adjudicated right to appropriate water made or held by the registrant.

Township 15 Range 3E, W.M.
North

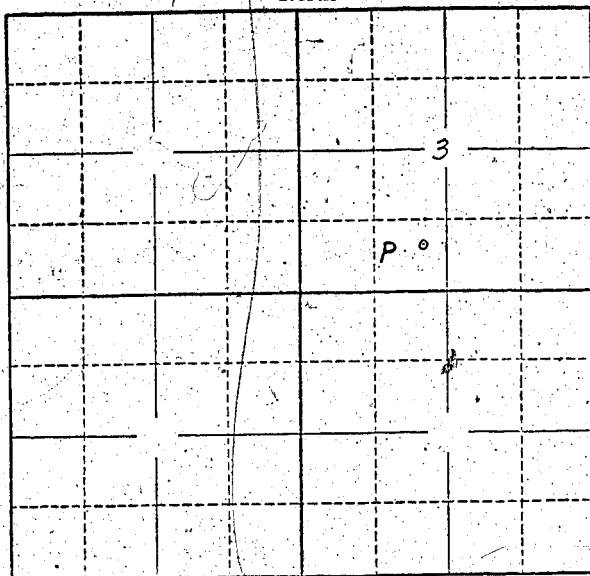

Locate well and acreage of irrigated land on plat.

Scale: 2" = 1 Mile

STATE OF OREGON

County of Multnomah

ss.

I, V.E. Preedy, being first duly sworn, do hereby certify that I have read the foregoing Registration Statement and that all of the items therein contained are true to the best of my knowledge and belief.

V.E. Preedy

(Signature of Registrant)

Subscribed and sworn to before me this 25th day of July, 1958.

My commission expires 2-15-61

Harvey J. Smyke

(Notary Public)

(SEAL)

CERTIFICATE OF REGISTRATION

STATE OF OREGON

County of Marion

ss.

This is to certify that the foregoing Registration Statement was received in the office of the State Engineer on the 22nd day of July, 1958, at 2:00 o'clock A. M. and has been duly recorded in said office in Book No. 11 of Registration Statements on page GR-2663

Witness my hand this 6th day of April, 1959

Lawrence A. Stearns

(State Engineer)

By

(Deputy)

GR-2663