

Registration Statement

REGISTRATION NO. GR-2827
CERTIFICATE NO. GR-2666

OF CLAIMANT OF RIGHT TO APPROPRIATE GROUND WATER

(Under Chapter 708, Oregon Laws 1955.)

TO THE STATE ENGINEER OF OREGON:

I, J. A. Friedman
of Woodburn County of Marion
State of Oreg., do hereby make application for a certificate of registration as evidence of a right to appropriate ground water.

1. Source from which water is withdrawn is Arund Well
(Flowing well, pump well, infiltration trench, or tunnel)
2. Location is: 1 mile North of Woodburn
(Approximate distance and direction from nearest city or town)

and is more particularly described as follows:

- (a) 1300 feet east & 60 feet South from NW 1/4 corner
(Give distance and bearing to corner of section or other legal subdivision)
being within NW 1/4 of S 1/4 of Sec. 8 Twp. 5 S Rge. 1 W
(Smallest legal subdivision) (N. or S.) (E. or W.)

or (b) within limits of recorded platted property, town or city:
in Lot _____, Block _____ of _____
(Name of plat or addition)

County of _____
(If within city or town, give name)

3. Construction Work was begun on Aug. 1952; was completed on Aug 1952
(Date) (Date)

and the ground water claimed was first used for the purposes set out below on Aug 1952
(Date)
since which time the water has been used intermittently during season
(Continuously or intermittently)
from Aug. 1952 to Oct. 1957
(Date) (Date)

4. Quantity of water claimed and used is 75 gallons per minute; _____ acre
feet per year.

5. Purpose or Purposes for which water is used Irrigation
(Domestic, irrigation, municipal, manufacturing, industrial, etc.)

6. Description of Well: Depth 125 feet. Type Drilled
(Dug or drilled)
diameter 8 inches. Elevation of ground at well site _____ feet, mean sea level.
(As near as known)
Depth to water table 15 feet.

7. Capacity of Well: unk g.p.m. with _____ feet drawdown.
_____ g.p.m. with _____ feet drawdown.


Date of test None

If Flowing Well: Measured discharge _____ g.p.m. on _____
(Date)

Shut-in pressure at ground surface _____ lbs. per sq. in. on _____
(Date)

Water is controlled by _____
(Cap, valve, etc.)

Sec. 8 Township 5S Range 1W, W.M.
North

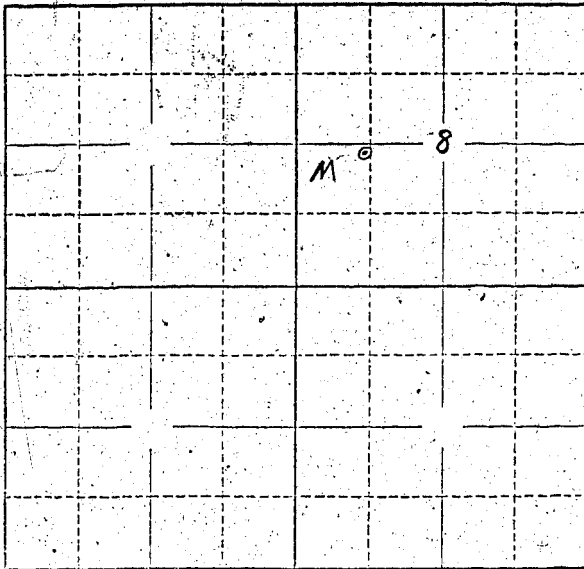

Locate well and acreage of irrigated land on plat.
Scale: 2" = 1 Mile

STATE OF OREGON

County of Marion ss.

I, J. Wiedeman, being first duly sworn, do hereby certify that I have read the foregoing Registration Statement and that all of the items therein contained are true to the best of my knowledge and belief.

J. Wiedeman
(Signature of Registrant)

Subscribed and sworn to before me this 28th day of July, 1958

My commission expires 12th June 1961 Wm. S. Bartholomew
(Notary Public)

(SEAL)

CERTIFICATE OF REGISTRATION

STATE OF OREGON

County of Marion ss.

This is to certify that the foregoing Registration Statement was received in the office of the State Engineer on the 28th day of July, 1958, at 3:00 o'clock P.M. and has been duly recorded in said office in Book No. 11 of Registration Statements on page GR-2666

~~Construction shall be completed by 10 and the water shall be applied to the land by 10~~

Witness my hand this 6th day of April, 1959

Wm. A. Murray
(State Engineer)

\$15.00

By (Deputy)

GR-2666