

RECEIVED
 JUL 25 1958
 STATE ENGINEER
 SALEM, OREGON

Registration Statement

OF CLAIMANT OF RIGHT TO APPROPRIATE GROUND WATER

TO THE STATE ENGINEER OF OREGON:

I, Lebe S. Dalby & Malcol Dalby, husband & wife
 of Rt 4, Box 195, Hillsboro, Oregon County of Washington
(Mailing address)

State of Oregon, do hereby make application for a certificate of registration as evidence of a right to appropriate ground water.

1. Source from which water is withdrawn is Flowing Well with Pump
(Flowing well, pump well, infiltration trench, or tunnel)
2. Location is: 6 mi S 1/2 M.E. Hillsboro, Oregon
(Approximate distance and direction from nearest city or town)

and is more particularly described as follows:

(a) 550 ft N 21° 0' W
(Give distance and bearing to corner of section or other legal subdivision)
 being within SE 1/4 30 + NW 1/4 31 of Sec. 30-44, Twp. 15, Rge. 2 W
(Smallest legal subdivision) (T or S.) (E or W.)

or (b) within limits of recorded platted property, town or city:
 in Lot _____ Block _____ of _____
(Name of plat or addition)

County of _____
(If within city or town, give name)

3. Construction Work was begun on March 1944; was completed on March 1944
(Date) (Date)

and the ground water claimed was first used for the purposes set out below on March 1944,
(Date)
 since which time the water has been used Continuously
(Continuously or intermittently)

from March 1944 to July 1958
(Date) (Date)

4. Quantity of water claimed and used is 75 gallons per minute; 5 acre feet per year.

5. Purpose or Purposes for which water is used exempt ~~Domestic~~ & Irrigation

(Domestic, irrigation, municipal, manufacturing, industrial, etc.)

6. Description of Well: Depth 280 feet. Type Drilled
(Dug or drilled)

diameter 6 inches. Elevation of ground at well site 200 feet, mean sea level.
(As near as known)

Depth to water table 60 feet.

7. Capacity of Well: 15 g.p.m. with 60 feet drawdown.

_____ g.p.m. with _____ feet drawdown.


Date of test 1957

If Flowing Well: Measured discharge 15 g.p.m. on March 1944
(Date)

Shut-in pressure at ground surface Nil lbs. per sq. in. on _____
(Date)

Water is controlled by Valve
(Cap, valve, etc.)

Township 1S Range 2W W.M.
North

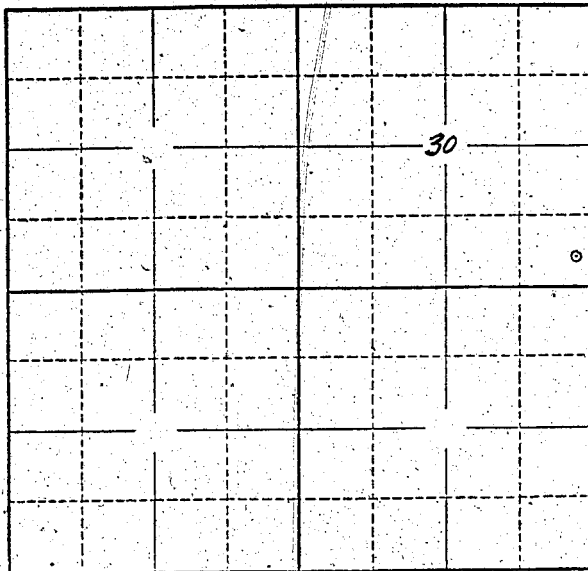

Locate well and acreage of irrigated land on plat.
Scale: 2" = 1 Mile

STATE OF OREGON

County of Washington } ss.

I, S. S. Dalby & Mabel Dalby, being first duly sworn, do hereby certify that I have read the foregoing Registration Statement and that all of the items therein contained are true to the best of my knowledge and belief.

S. S. Dalby
(Signature of Registrant)

Subscribed and sworn to before me this 24 day of July, 1958

My commission expires 11-22-61

[Signature]
(Notary Public)

(SEAL)

CERTIFICATE OF REGISTRATION

STATE OF OREGON } ss.
County of Marion

This is to certify that the foregoing Registration Statement was received in the office of the State Engineer on the 25 day of July, 1958, at 8:00 o'clock A.M. and has been duly recorded in said office in Book No. 11 of Registration Statements on page GR-2667

Witness my hand this 6th day of April, 1959

[Signature]
(State Engineer)

\$15.00

By _____ (Deputy)