RECEIVED
JUL 25 1958
STATE ENGINEER
SALEM, OREGON

REGISTRATION NO. GR-2829

Registration Statement

CERTIFICATE NO. GR- 2668

OF CLAIMANT OF RIGHT TO APPROPRIATE GROUND WATER

(Under Chapter 708, Oregon Laws 1955.)

TO THE STATE ENGINEER OF OREGON:

I, John [illegible]

of Rt 2 Box 288 Eugene County of [illegible]

State of Oregon, do hereby make application for a certificate of registration as evidence of a right to appropriate ground water.

1. **Source from which water is withdrawn is** [illegible] (Flowing well, pump well, infiltration trench, or tunnel)

2. **Location is:** [illegible] (Approximate distance and direction from nearest city or town)

and is more particularly described as follows:

(a) 1850 feet North and 1728 feet East [illegible] (Give distance and bearing to corner of section or other legal subdivision)

being within NE¼ of SW¼ (Smallest legal subdivision) of Sec. 10, Twp. 17 South (N. or S.), Rge. 3 West (E. or W.)

or (b) within limits of recorded platted property, town or city:

in Lot ...., Block .... of .... (Name of plat or addition)

.... (If within city or town, give name) County of Lane

3. **Construction Work** was begun on unk (Date); was completed on [illegible] 1940 (Date)

and the ground water claimed was first used for the purposes set out below on [illegible] (Date)

since which time the water has been used Continuously (Continuously or intermittently)

from 1940 (Date) to 1958 (Date)

4. **Quantity** of water claimed and used is 120 gallons per minute; [redacted] acre-feet per year. (See 14)

5. **Purpose or Purposes** for which water is used Irrigation

(Domestic, irrigation, municipal, manufacturing, industrial, etc.)

6. **Description of Well:** Depth 20 feet. Type [illegible] (Dug or drilled)

diameter 9" inches. Elevation of ground at well site 420 (As near as known) feet, mean sea level.

Depth to water table 13 feet.

7. **Capacity of Well:** 120 g.p.m. with No feet drawdown.

.... g.p.m. with .... feet drawdown.

Date of test [illegible]

If Flowing Well: Measured discharge .... g.p.m. on .... (Date)

Shut-in pressure at ground surface .... lbs. per sq. in. on .... (Date)

Water is controlled by .... (Cap, valve, etc.)

8. **Casing:** (Give diameter, commercial specifications and depth below ground surface of each casing size.)

2 inch diameter Standard galvanized pipe from Surface to [illegible] feet

.... inch diameter .... from .... to .... feet

.... inch diameter .... from .... to .... feet

.... inch diameter .... from .... to .... feet

Describe and show depth of shoe, plug, adapter, liner or other details: [illegible] six feet apart, to a depth of 20 feet, and coupled together at the top with a manifold.

9. **Perforated Casings or Screens:**

.... from .... to ....
(Number per foot and size of perforations, or describe screen)

.... from .... to ....

.... from .... to ....

.... from .... to ....

10. **Log of Well:** (Describe each stratum or formation clearly, indicate if water bearing, and give thickness and depth as indicated.)

MATERIAL	Thickness (Feet)	Depth to Bottom (Feet)
Gravel all the way	20	20
Water level even with		
the water level of the McKenzie		
River. It is approximately 10 feet		
below the surface in the summer		
months		

GR-2668

If log of well is not available, give name and address of driller. Not Known

11. **Infiltration Trench:** Covered or open .....

Dimensions: Length ..... ft. Minimum depth ..... ft. Maximum depth ..... ft.

Bottom width ..... ft. Discharge ..... g.p.m. Date of test .....

12. **Tunnel:** Type of lining .....

Dimensions: ..... (Length, course, and cross sectional size)

Position of water bearing stratum with reference to portal of tunnel .....

Log of tunnel: (Preceding table for log of well may be used, if desired. Give footage from portal and character of materials, as pertinent.)

13. **Pumping Equipment:**

(a) Pump Fairbanks Morse 1½ in Centrifugal Capacity 120 g.p.m.
(Make, type and size)

(b) Motor Reliance 5 HP
(Type and horsepower)

14. Location of area irrigated or to be irrigated, or place of use if for purposes other than irrigation.

Township North or South	Range E. or W. of Willamette Meridian	Section	Forty-acre Tract	Number Acres To Be Irrigated	Date of Reclamation
T17S	R3W	10	NE¼ of SW¼	10±	1940

15. If the ground water supply is supplemental to an existing water supply, identification of any application for a permit, permit, certificate or adjudicated right to appropriate water made or held by the registrant.

.....

.....

GR-12668

Township 17 South Range 3 West, W.M.

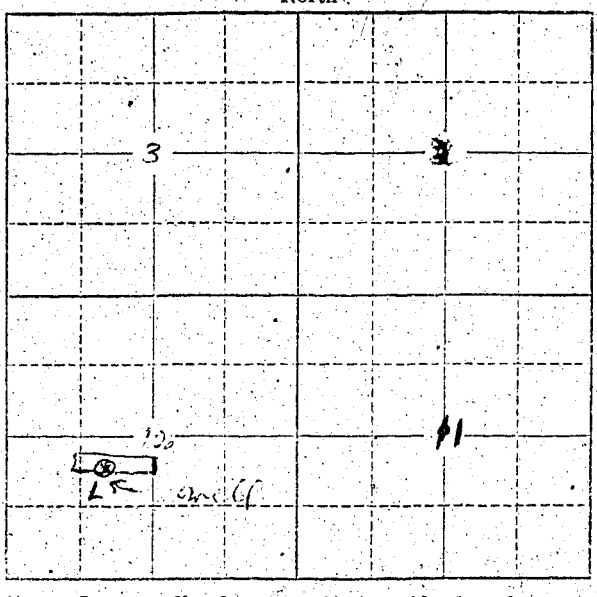

Locate well and acreage of irrigated land on plat.

Scale: 2" = 1 Mile

STATE OF OREGON
County of [illegible] } ss.

I, [illegible], being first duly sworn, do hereby certify that I have read the foregoing Registration Statement and that all of the items therein contained are true to the best of my knowledge and belief.

[illegible]
(Signature of Registrant)

Subscribed and sworn to before me this 23 day of July, 19[illegible]

My commission expires [illegible]
(Notary Public)

(SEAL)

CERTIFICATE OF REGISTRATION

STATE OF OREGON
County of Marion } ss.

This is to certify that the foregoing Registration Statement was received in the office of the State Engineer on the 28th day of July, 1955, at [illegible] o'clock [illegible] M. and has been duly recorded in said office in Book No. 11 of Registration Statements on page GR- 2668

~~Construction shall be completed by [illegible] and the water completely applied to beneficial use by [illegible]~~

Witness my hand this 6th day of April, 19 59

[illegible]
(State Engineer)

By [illegible]
(Deputy)

GR- 2668