

Registration Statement

OF CLAIMANT OF RIGHT TO APPROPRIATE GROUND WATER

TO THE STATE ENGINEER OF OREGON:

I, JOHN B. PEYTON

of 8245 S. W. 170th, Beaverton County of Washington

State of Oregon, do hereby make application for a certificate of registration as evidence of a right to appropriate ground water.

1. Source from which water is withdrawn is drilled well

(Flowing well, pump well, infiltration trench, or tunnel)

2. Location is Three (3) miles southwest of Beaverton, Oregon

(Approximate distance and direction from nearest city or town)

and is more particularly described as follows:

(a) 1800' S.W. of N.E. corner of Section 30

(Give distance and bearing to corner of section or other legal subdivision)

being within _____ of Sec. 30, Twp. 1S, Rge. 1W

(Smallest legal subdivision)

(N. or S.)

(E. or W.)

(E. or W.)

or (b) within limits of recorded platted property, town or city: _____

in Lot _____, Block _____ of Aldrich Acres

(Name of plat or addition)

County of Washington

(If within city or town, give name)

3. Construction Work was begun on 1940; was completed on September, 1940

(Date)

(Date)

and the ground water claimed was first used for the purposes set out below on September, 1940

(Date)

since which time the water has been used continuously

(Continuously or intermittently)

from 1940 to 1958

(Date)

(Date)

4. Quantity of water claimed and used is 12 gallons per minute; _____ acre feet per year.

5. Purpose or Purposes for which water is used exempt household, garden, lawn,

Some irrigating (with lawn and garden about 1/2 acre, adjacent to house)

(Domestic, irrigation, municipal, manufacturing, industrial, etc.)

6. Description of Well: Depth 241 feet. Type drilled

(Dug or drilled)

diameter 6 inches. Elevation of ground at well site 380 feet, mean sea level.

(As near as known)

Depth to water table 170 feet.

7. Capacity of Well: 20 g.p.m. with 25 feet drawdown.

_____ g.p.m. with _____ feet drawdown.

Date of test 1956-1957

If Flowing Well: Measured discharge _____ g.p.m. on _____

(Date)

Shut-in pressure at ground surface _____ lbs. per sq. in. on _____

(Date)

Water is controlled by _____

(Cap, valve, etc.)

8. Casing: (Give diameter, commercial specifications and depth below ground surface of each casing size.)

6 inch diameter from 0 to 130 feet
..... inch diameter from to feet
..... inch diameter from to feet
..... inch diameter from to feet

Describe and show depth of shoe, plug, adapter, liner or other details:

9. Perforated Casings or Screens:

(Number per foot and size of perforations, or describe screen) from to

..... from to

..... from to

..... from to

10. Log of Well: (Describe each stratum or formation clearly, indicate if water bearing, and give thickness and depth as indicated,)

MATERIAL	Thickness (Feet)	Depth to Bottom (Feet)
Earth, clay, rock		

If log of well is not available, give name and address of driller. Francis Livermore, Baney Rd., Beaverton, Oregon; deepened by Art Gaunt, Aloha, Oregon.

11. Infiltration Trench: Covered or open _____
 Dimensions: Length _____ ft. Minimum depth _____ ft. Maximum depth _____ ft.
 Bottom width _____ ft. Discharge _____ g.p.m. Date of test _____

12. Tunnel: Type of lining _____
 Dimensions: _____
(Length, course, and cross sectional size)
 Position of water bearing stratum with reference to portal of tunnel _____

Log of tunnel: (Preceding table for log of well may be used, if desired. Give footage from portal and character of materials, as pertinent.)

13. Pumping Equipment:

(a) Pump Myers Submersible Capacity 12 g.p.m.
(Make, type and size)
 (b) Motor 1 H.P.
(Type and horsepower)


14. Location of area irrigated or to be irrigated, or place of use if for purposes other than irrigation.

Township North or South	Range E. or W. of Willamette Meridian	Section	Forty-acre Tract	Number Acres To Be Irrigated	Date of Reclamation
T 1 S	R 1 W	30	NW 1/4 of NE 1/4	0.51 acres	1940

15. If the ground water supply is supplemental to an existing water supply, identification of any application for a permit, permit, certificate or adjudicated right to appropriate water made or held by the registrant.
 Well is our only water

Section 30

Township 1S Range RLW W.M.
North

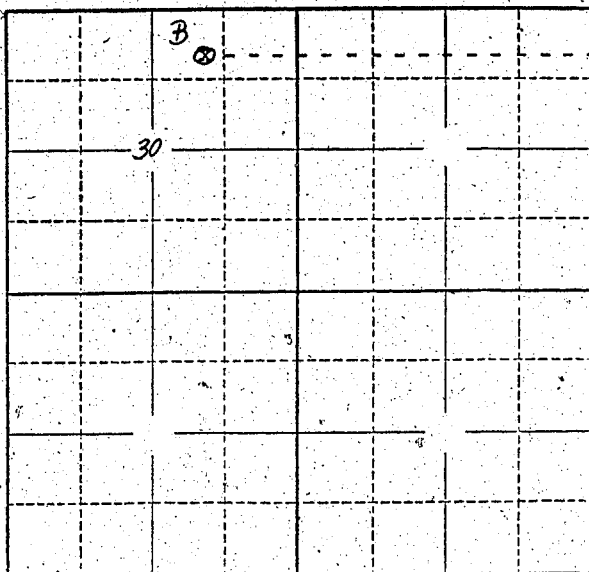

Locate well and acreage of irrigated land on plat.

Scale: 2" = 1 Mile

STATE OF OREGON

County of Washington } ss.

I, John B. Peyton, being first duly sworn, do hereby certify that I have read the foregoing Registration Statement and that all of the items therein contained are true to the best of my knowledge and belief.

John B. Peyton
(Signature of Registrant)

Subscribed and sworn to before me this 25th day of July, 1955

My commission expires NOTARY PUBLIC FOR OREGON
MY COMMISSION EXPIRES JAN. 9, 1957

William M. ...
(Notary Public)

(SEAL)

CERTIFICATE OF REGISTRATION

STATE OF OREGON } ss.
County of Marion

This is to certify that the foregoing Registration Statement was received in the office of the State Engineer on the 25 day of July, 1955, at 8:00 o'clock A. M. and has been duly recorded in said office in Book No. 11 of Registration Statements on page GR 2670

Witness my hand this 6th day of April, 1959

Stuart A. Stanley
(State Engineer)

By _____ (Deputy)

#1500

GR - 2670