

RECEIVED
JUL 25 1935
STATE ENGINEER
SALEM, OREGON

Registration No. GR - 2837
Certificate No. GR 2673

Registration Statement

OF CLAIMANT OF RIGHT TO APPROPRIATE GROUND WATER

TO THE STATE ENGINEER OF OREGON:

I, MRS. NELLIE KOON
of 2020 RIVER ROAD JUNCTION CITY County of LANE
(Mailing address)

State of ORE., do hereby make application for a certificate of registration as evidence of a right to appropriate ground water.

1. Source from which water is withdrawn is PUMP WELL
(Flowing well, pump well, infiltration trench, or tunnel)
2. Location is: 2 MILES S OF JUNCTION CITY
(Approximate distance and direction from nearest city or town)

and is more particularly described as follows:

(a) 1860' S. 34° 30' E from center of Section 4
(Give distance and bearing to corner of section or other legal subdivision)

being within S. 1/4 S. E. 1/4 of Sec. 4, Twp. 16 S, Rge. 4 W
(Smallest legal subdivision) (N. or S.) (E. or W.)

or (b) within limits of recorded platted property, town or city:

in Lot _____, Block _____ of _____
(Name of plat or addition)

County of _____
(If within city or town, give name)

3. Construction Work was begun on JUNE 1935; was completed on JUNE 1935
(Date) (Date)

and the ground water claimed was first used for the purposes set out below on JUNE 1935
(Date)

since which time the water has been used EVERY THIRD YEAR
(Continuously or intermittently)

from JUNE 1935 to PRESENT
(Date) (Date)

4. Quantity of water claimed and used is 457 gallons per minute; 2.04 acre feet per year.

5. Purpose or Purposes for which water is used IRRIGATION
(Domestic, irrigation, municipal, manufacturing, industrial, etc.)

6. Description of Well: Depth 24 feet. Type DRIVEN 2" 4" PIPES
(Dug or drilled)

diameter 4 inches. Elevation of ground at well site 350 feet, mean sea level.
(As near as known)

Depth to water table 12 feet.

7. Capacity of Well: 500 g.p.m. with 18 feet drawdown.
_____ g.p.m. with _____ feet drawdown.

Date of test _____


If Flowing Well: Measured discharge _____ g.p.m. on _____
(Date)

Shut-in pressure at ground surface _____ lbs. per sq. in. on _____
(Date)

Water is controlled by _____
(Chg. valve, etc.)

Township 16S Range 4W W.M.

North

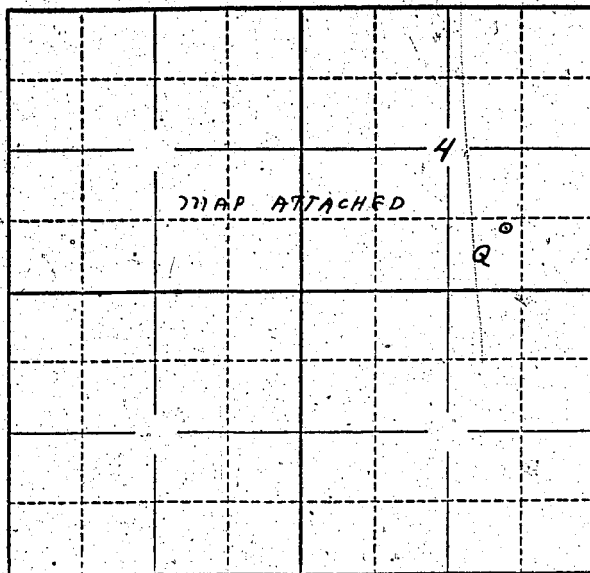

Locate well and acreage of irrigated land on plat.

Scale: 2" = 1 Mile

STATE OF OREGON

County of Lane } ss.

I, Nellie Korn, being first duly sworn, do hereby certify that I have read the foregoing Registration Statement and that all of the items therein contained are true to the best of my knowledge and belief.

Nellie Korn
(Signature of Registrant)

Subscribed and sworn to before me this 25 day of July, 1955

My commission expires Nov 27, 1959

James C. Jones
(Notary Public)

(SEAL)

CERTIFICATE OF REGISTRATION

STATE OF OREGON } ss.
County of Marion

This is to certify that the foregoing Registration Statement was received in the office of the State Engineer on the 28 day of July, 1955, at 8:00 o'clock A.M. and has been duly recorded in said office in Book No. 11 of Registration Statements on page GR 2673

Witness my hand this 25th day of May, 1959

Laura A. Stanley
(State Engineer)

By _____
(Deputy)

\$22.80

GR - 2673