RECEIVED
JUL 26 1958
STATE ENGINEER
SALEM, OREGON

Registration No. GR-2841

Certificate No. GR 2678

Registration Statement

OF CLAIMANT OF RIGHT TO APPROPRIATE GROUND WATER

TO THE STATE ENGINEER OF OREGON:

I, Ben D. Halsey,

of Route 1, Box 480, Corvallis (Mailing address) County of Benton

State of Oregon, do hereby make application for a certificate of registration as evidence of a right to appropriate ground water.

1. **Source** from which water is withdrawn is pump well (Flowing well, pump well, infiltration trench, or tunnel)

2. **Location** is: 4 miles NE of Corvallis, Oregon (Approximate distance and direction from nearest city or town);

and is more particularly described as follows:

(a) approx. 700' N 30 E from 1/4 section corner bet 20 and 29 (Give distance and bearing to corner of section or other legal subdivision)

being within SW¼ SE¼ (Smallest legal subdivision) of Sec. 20, Twp. 11S (N. or S.), Rge. 4W (E. or W.)

or (b) within limits of recorded platted property, town or city:

in Lot ....., Block ..... of ..... (Name of plat or addition)

..... (If within city or town, give name) County of .....

3. **Construction Work** was begun on May 1948 (Date); was completed on May 1948 (Date)

and the ground water claimed was first used for the purposes set out below on May 1948 (Date),

since which time the water has been used intermittently (Continuously or intermittently)

from 1948 (Date) to 1958 (Date)

4. **Quantity** of water claimed and used is 420/ (42 - 10 gal. sprinklers) gallons per minute; ..... acre feet per year.

5. **Purpose or Purposes** for which water is used irrigation

..... (Domestic, irrigation, municipal, manufacturing, industrial, etc.)

6. **Description of Well:** Depth 30 feet. Type drilled (Dug or drilled)

diameter 12 inches. Elevation of ground at well site 215 (As near as known) feet, mean sea level.

Depth to water table 18 feet.

7. **Capacity of Well:** 500 g.p.m. with none feet drawdown.

..... g.p.m. with ..... feet drawdown.

Date of test .....

If Flowing Well: Measured discharge ..... g.p.m. on ..... (Date)

Shut-in pressure at ground surface ..... lbs. per sq. in. on ..... (Date)

Water is controlled by ..... (Cap, valve, etc.)

8. **Casing:** (Give diameter, commercial specifications and depth below ground surface of each casing size.)

12 inch diameter full 30' from ..... to ..... feet

..... inch diameter ..... from ..... to ..... feet

..... inch diameter ..... from ..... to ..... feet

..... inch diameter ..... from ..... to ..... feet

Describe and show depth of shoe, plug, adapter, liner or other details:

pump set 6' below surface

9. **Perforated Casings or Screens:**

no data available from ..... to .....
(Number per foot and size of perforations, or describe screen)

..... from ..... to .....

..... from ..... to .....

..... from ..... to .....

10. **Log of Well:** (Describe each stratum or formation clearly, indicate if water bearing, and give thickness and depth as indicated.)

MATERIAL	Thickness (Feet)	Depth to Bottom (Feet)
no information available		

GR 2678

If log of well is not available, give name and address of driller. Burton Ashalm, Route 1, Corvallis (not a regular well driller)

11. **Infiltration Trench:** Covered or open .....

Dimensions: Length ..... ft. Minimum depth ..... ft. Maximum depth ..... ft.

Bottom width ..... ft. Discharge ..... g.p.m. Date of test .....

12. **Tunnel:** Type of lining .....

Dimensions: .....
(Length, course, and cross section size)

Position of water bearing stratum with reference to portal of tunnel .....

Log of tunnel: (Preceding table for log of well may be used, if desired. Give footage from portal and character of materials, as pertinent.)

13. **Pumping Equipment:**

(a) Pump Fairbanks Morse centrifugal (Make, type and size) Capacity 600 g.p.m.

(b) Motor 10 hp 3 phase (Type and horsepower)

14. Location of area irrigated or to be irrigated, or place of use if for purposes other than irrigation.

Township North or South	Range E. or W. of Willamette Meridian	Section	Forty-acre Tract	Number Acres To Be Irrigated	Date of Reclamation
11S	4W	20	SW¼ SE¼	14	1938
"	"	29	SE¼ SE¼	2	1938
"	"	29	NE¼ NE¼	4	"
				20.0	
				20	

15. If the ground water supply is supplemental to an existing water supply, identification of any application for a permit, permit, certificate or adjudicated right to appropriate water made or held by the registrant.

no

GR 2678

Township 11 S Range 4 W, W.M.

North

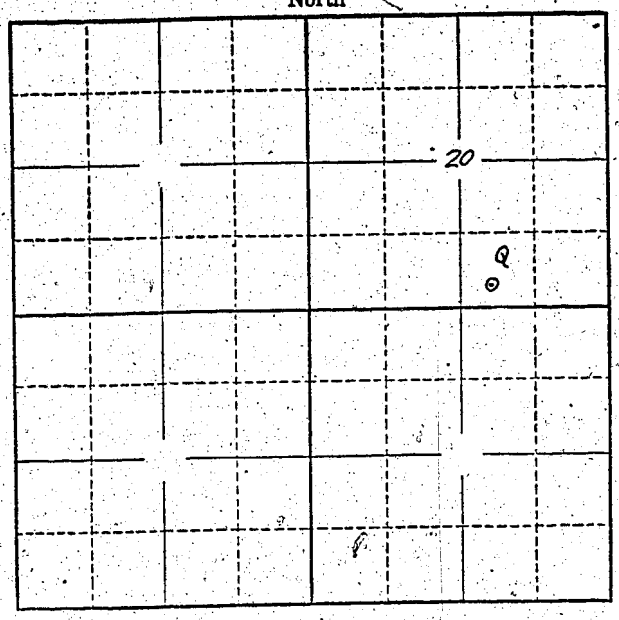

Locate well and acreage of irrigated land on plat.

Scale: 2" — 1 Mile

STATE OF OREGON }ss.
County of [illegible]

I, [illegible], being first duly sworn, do hereby certify that I have read the foregoing Registration Statement and that all of the items therein contained are true to the best of my knowledge and belief.

[illegible]
(Signature of Registrant)

Subscribed and sworn to before me this 25 day of [illegible] 19 58

My commission expires [illegible]

[illegible]
(Notary Public)

(SEAL)

CERTIFICATE OF REGISTRATION

STATE OF OREGON }ss.
County of Marion

This is to certify that the foregoing Registration Statement was received in the office of the State Engineer on the 28th day of July, 1958, at 8:00 o'clock A M. and has been duly recorded in said office in Book No. 11 of Registration Statements on page GR-2678

Witness my hand this 25th day of May, 1959

[illegible]
(State Engineer)

By [illegible]
(Deputy)

$15.00

GR-2678