

Registration No. GR. - 2842
Certificate No. GR. 2679

Registration Statement

OF CLAIMANT OF RIGHT TO APPROPRIATE GROUND WATER

TO THE STATE ENGINEER OF OREGON:

I, Clement H. Ault

of Route 1, Box 224, Central Point, County of Jackson
(Mailing address)

State of Oregon, do hereby make application for a certificate of registration as evidence of a right to appropriate ground water.

1. Source from which water is withdrawn is Sump
(Flowing well, pump well, infiltration trench, or tunnel)

2. Location is: 1 1/2 miles West of Central Point, Oregon
(Approximate distance and direction from nearest city or town)

and is more particularly described as follows:

(a) 1630 feet East and 1775 feet South of NW corner of DIC #45
(Give distance and bearing to corner of section or other legal subdivision)

being within N 1/2 NE 1/4 NW 1/4 of Sec. 9, Twp. 37 S., Rge. 2 W.
(Smallest legal subdivision) (N. or S.) (E. or W.)

or (b) within limits of recorded platted property, town or city:

in Lot _____, Block _____ of _____
(Name of plat or addition)

County of _____
(If within city or town, give name)

3. Construction Work was begun on 1930 (est.); was completed on 1951
(Date) (Date)

and the ground water claimed was first used for the purposes set out below on 1930 (est.)
(Date)

since which time the water has been used continuously
(Continuously or Intermittently)

from 1930 to present
(Date) (Date)

4. Quantity of water claimed and used is 50 gallons per minute; 23 acre feet per year.

5. Purpose or Purposes for which water is used _____

irrigation
SUMP (Domestic, irrigation, municipal, manufacturing, industrial, etc.)

6. Description of ~~well~~: Depth 20 feet. Type Dug
(Dug or drilled)

diameter 20'x50' ~~well~~. Elevation of ground at well site 1290 (est.) feet, mean sea level.
(As near as known)

Depth to water table 2-3 feet.

7. Capacity of Well: _____ g.p.m. with _____ feet drawdown.

_____ g.p.m. with _____ feet drawdown.


Date of test none

If Flowing Well: Measured discharge none g.p.m. on _____
(Date)

Shut-in pressure at ground surface _____ lbs. per sq. in. on _____
(Date)

Water is controlled by _____
(Cap, valve, etc.)

Township 37S Range 2W, W.M.
North

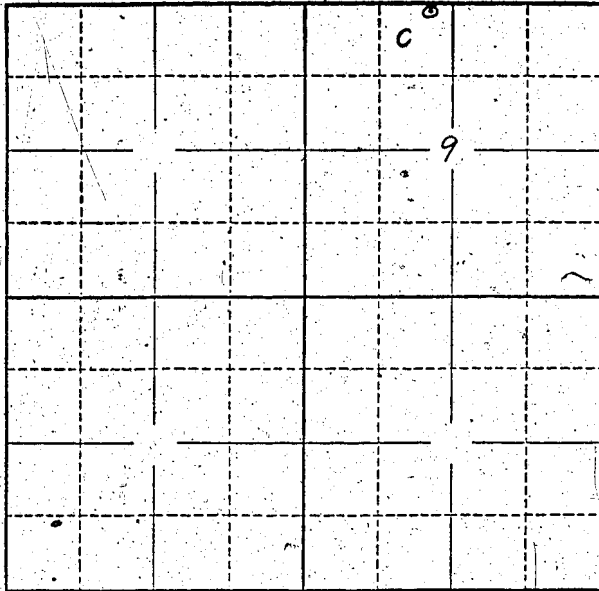

Locate well and acreage of irrigated land on plat.
Scale: 2" = 1 Mile

STATE OF OREGON

County of JACKSON

} ss.

I, Clement H. Ault, being first duly sworn, do hereby certify that I have read the foregoing Registration Statement and that all of the items therein contained are true to the best of my knowledge and belief.

(Signature of Registrant)

Subscribed and sworn to before me this 24th day of July, 19 58

My commission expires August 25, 1958

(Notary Public)

(SEAL)

CERTIFICATE OF REGISTRATION

STATE OF OREGON

County of Marion

} ss.

This is to certify that the foregoing Registration Statement was received in the office of the State Engineer on the 28 day of July, 19 58, at 8.10 o'clock A. M. and has been duly recorded in said office in Book No. 11 of Registration Statements on page GR 2679

Witness my hand this 25th day of May, 19 59

(State Engineer)

By

(Deputy)

GR - 2679

\$15.00