

RECEIVED
JUL 23 1953
STATE ENGINEER
SALEM, OREGON

Registration No. GR - 2843

Certificate No. GR - 2680

Registration Statement

OF CLAIMANT OF RIGHT TO APPROPRIATE GROUND WATER

TO THE STATE ENGINEER OF OREGON:

I, Herbert Reeves Sinnard

of Routel. box 285 Highlandway Corvallis County of Benton
(Mailing address)

State of Oregon, do hereby make application for a certificate of registration as evidence of a right to appropriate ground water.

1. Source from which water is withdrawn is Pump well
(Flowing well, pump well, infiltration trench, or tunnel)

2. Location is: One mile north of Corvallis
(Approximate distance and direction from nearest city or town)

and is more particularly described as follows:

(a) 20.1 chainseast 37.5 South of N. W. Corner of Claim #17
(Give distance and bearing to corner of section or other legal subdivision)

being within N.E. of S.W of Sec. 23, Twp. 11 S, Rge. 5 W
(Smallest legal subdivision)

or (b) within limits of recorded platted property, town or city:

in Lot _____, Block _____ of _____
(Name of plat or addition)

_____ County of _____
(If within city or town, give name)

3. Construction Work was begun on Dec. 15, 1952; was completed on Dec. 29, 1952
(Date)

and the ground water claimed was first used for the purposes set out below on March 1953
(Date)

since which time the water has been used Continuously
(Continuously or intermittently)

from March 1953 to present date
(Date)

4. Quantity of water claimed and used is 15 gallons per minute; approx 2 acre feet per year.

5. Purpose or Purposes for which water is used Domestic and Irrigation

(Domestic, irrigation, municipal, manufacturing, industrial, etc.)

6. Description of Well: Depth 146 feet. Type Drilled
(Dug or drilled)

diameter 6 inches. Elevation of ground at well site 300 feet, mean sea level.
(As near as known)

Depth to water table 246 feet.

7. Capacity of Well: 15 g.p.m. with _____ feet drawdown.

_____ g.p.m. with _____ feet drawdown.


Date of test Dec 1952

If Flowing Well: Measured discharge _____ g.p.m. on _____
(Date)

Shut-in pressure at ground surface _____ lbs. per sq. in. on _____
(Date)

Water is controlled by _____
(Cap, valve, etc.)

Township 11 S Range 5W, W.M.
North

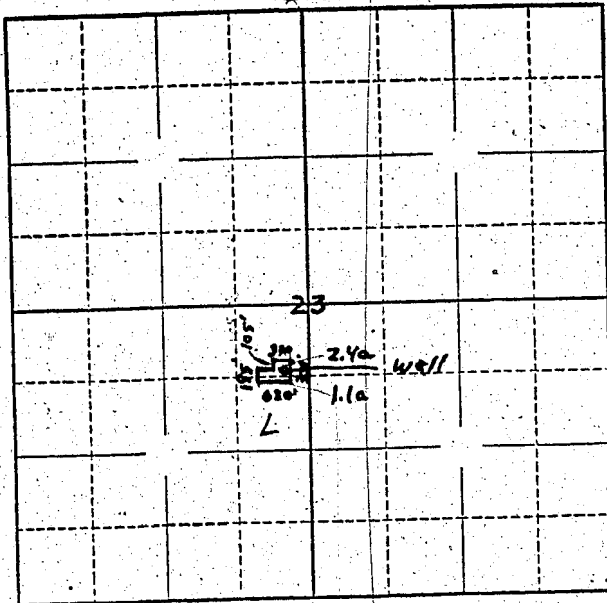

Locate well and acreage of irrigated land on plat.

Scale: 4" = 1 Mile
4" = 1 Mile

STATE OF OREGON

County of Benton

} ss.

I, Herbert Reeves Sinnard, being first duly sworn, do hereby certify that I have read the foregoing Registration Statement and that all of the items therein contained are true to the best of my knowledge and belief.

Herbert Reeves Sinnard
(Signature of Registrant)

Subscribed and sworn to before me this 24 day of April, 1958

My commission expires NOTARY PUBLIC FOR OREGON
My Commission Expires Aug. 21, 1960.

Qua M. Sawson
(Notary Public)

(SEAL)

CERTIFICATE OF REGISTRATION

STATE OF OREGON

County of Marion

} ss.

This is to certify that the foregoing Registration Statement was received in the office of the State Engineer on the 28th day of July, 1958, at 8:00 o'clock A.M. and has been duly recorded in said office in Book No. 11 of Registration Statements on page GR-2680

Witness my hand this 25th day of May, 1959

Luva A. Stanley
(State Engineer)

By _____
(Deputy)

\$15.00

GR - 2680