

Registration No. GR - 2844
Certificate No. GR - 2681

Registration Statement

OF CLAIMANT OF RIGHT TO APPROPRIATE GROUND WATER

TO THE STATE ENGINEER OF OREGON:

I, W. H. Arnold

of Route 4, Box 297, Medford, County of Jackson
(Mailing address)

State of Oregon, do hereby make application for a certificate of registration as evidence of a right to appropriate ground water.

1. Source from which water is withdrawn is (Sump) Infiltration Trench
(Flowing well, pump well, infiltration trench, or tunnel)

2. Location is: 4 miles South and West of Medford, Oregon
(Approximate distance and direction from nearest city or town)

and is more particularly described as follows:

(a) 1115 feet South and 320 feet West from the NW corner DLG #78'
(Give distance and bearing to corner of section or other legal subdivision)

being within SW 1/4 NW 1/4 NW 1/4 of Sec. 34, Twp. 37 S., Rge. 2 W.
(Smallest legal subdivision) (N. or S.) (E. or W.)

or (b) within limits of recorded platted property, town or city:

in Lot , Block of
(Name of plat or addition)

County of
(If within city or town, give name)

3. Construction Work was begun on Nov. 8, 1951; was completed on Nov. 3, 1951
(Date) (Date)

and the ground water claimed was first used for the purposes set out below on May 1952
(Date)

since which time the water has been used continuously
(Continuously or Intermittently)

from May 1952 to present
(Date) (Date)

4. Quantity of water claimed and used is 100 gallons per minute; 41 acre feet per year

5. Purpose or Purposes for which water is used irrigation

SUMP (Domestic, irrigation, municipal, manufacturing, industrial, etc.)

6. Description of ~~well~~: Depth 12 feet. Type Dug
(Dug or drilled)

diameter 30" x 55" ~~well~~. Elevation of ground at well site 1120 feet, mean sea level.
(As near as known)

Depth to water table 5.0 feet.

7. Capacity of Well: 100 g.p.m. with 9 feet drawdown in 6 hours
 g.p.m. with feet drawdown.


Date of test noted from use.

If Flowing Well: Measured discharge g.p.m. on
(Date)

Shut-in pressure at ground surface lbs. per sq. in. on
(Date)

Water is controlled by
(Cap, valve, etc.)

Township 37 S Range 2 W W.M.
North

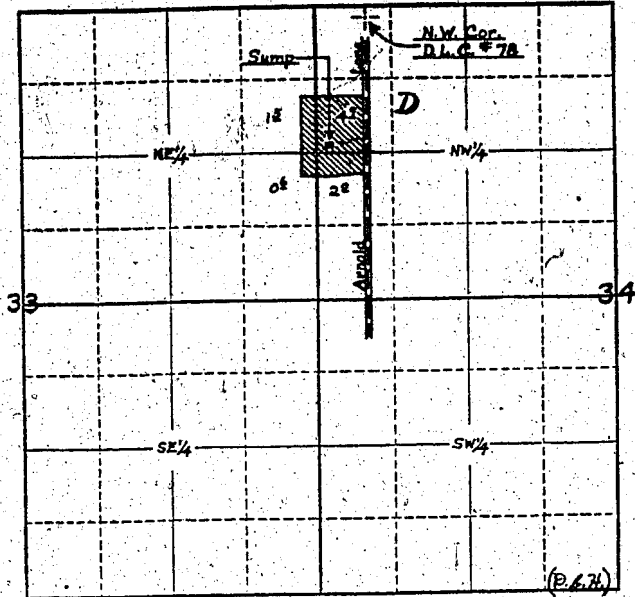

Locate well and acreage of irrigated land on plat.
Scale: 4" = 1 Mile

STATE OF OREGON

County of Jackson } ss.

I, W. H. Arnold, being first duly sworn, do hereby certify that I have read the foregoing Registration Statement and that all of the items therein contained are true to the best of my knowledge and belief.

X *W. H. Arnold*
(Signature of Registrant)

Subscribed and sworn to before me this 25th day of July 19 58

My commission expires August 25, 1958

(Notary Public)

(SEAL)

CERTIFICATE OF REGISTRATION

STATE OF OREGON

County of Marion } ss.

This is to certify that the foregoing Registration Statement was received in the office of the State Engineer on the 25th day of July 19 58, at 5:00 o'clock A.M. and has been duly recorded in said office in Book No. 11 of Registration Statements on page GR 268!

Witness my hand this 25th day of May 1959

W. A. Stanley
(State Engineer)

By _____ (Deputy)

\$15.00

GR - 268!