

RECEIVED
STATE ENGINEER
SALES SECTION

Registration No. GR. - 2845

Certificate No. GR. 3972

Registration Statement

RECEIVED
STATE ENGINEER
SALES SECTION

OF CLAIMANT OF RIGHT TO APPROPRIATE GROUND WATER

TO THE STATE ENGINEER OF OREGON:

I, PETE FUGHE

of 11611 S.E. FURBER RD. Milwau, OR County of CLACKAMAS

State of OREGON, do hereby make application for a certificate of registration as evidence of a right to appropriate ground water.

1. Source from which water is withdrawn is Pump Well
(Flowing well, pump well, infiltration trench, or tunnel)

2. Location is: 3 MILES EAST OF MILWAUKIE
(Approximate distance and direction from nearest city or town)

and is more particularly described as follows:

(a) N 32° 20' W, 2725 FEET FROM SE CORNER OF SEC. 32
(Give distance and bearing to corner of section or other legal subdivision)

being within NW 1/4 SE 1/4 of Sec. 32, Twp. 15, Rge. 2E
(Smallest legal subdivision) (N. or S.) (E. or W.)

(b) within limits of recorded platted property, town or city:

in Lot 32, Block 18 of 28
(Name of plat or addition)

County of Clackamas, OR
(If within city or town, give name)

3. Construction Work was begun on 1937 (copy); was completed on 1937 (copy)
(Date) (Date)

and the ground water claimed was first used for the purposes set out below on when completed 1937
(Date)

since which time the water has been used intermittently
(Continuously or intermittently)

from June (copy) to Sept. (copy) 1958
(Date) (Date)

4. Quantity of water claimed and used is 30 gallons per minute; 2 acre feet per year.

5. Purpose or Purposes for which water is used irrigation during crop season
irrigation (truck garden)
(Domestic, irrigation, municipal, manufacturing, industrial, etc.)

6. Description of Well: Depth 114 feet. Type DRILLED
(Dug or drilled)

diameter 6 inches. Elevation of ground at well site 160 feet, mean sea level.
(As near as known)

Depth to water table _____ feet.

7. Capacity of Well: 30 g.p.m. with _____ feet drawdown.

_____ g.p.m. with _____ feet drawdown.


Date of test _____

If Flowing Well: Measured discharge _____ g.p.m. on _____
(Date)

Shut-in pressure at ground surface _____ lbs. per sq. in. on _____
(Date)

Water is controlled by _____
(Cap, valve, etc.)

Township 15 Range 2E, W.M.
North

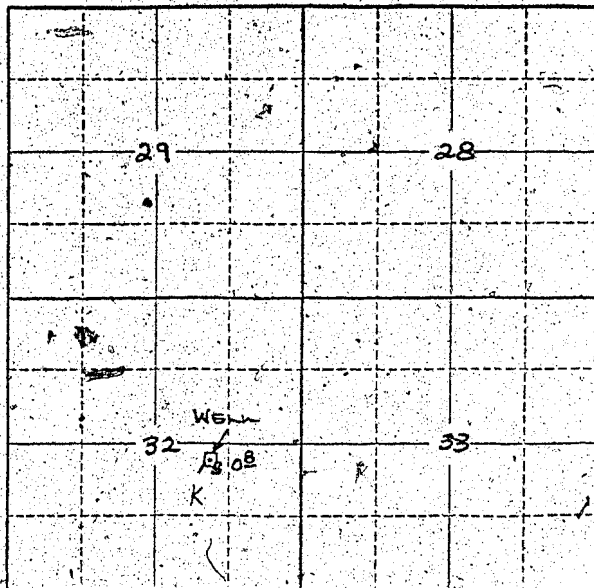

Locate well and acreage of irrigated land on plat.
Scale: 2" = 1 Mile

STATE OF OREGON

County of Clatsop } ss.

I, Pete Fucile being first duly sworn, do hereby certify that I have read the foregoing Registration Statement and that all of the items therein contained are true to the best of my knowledge and belief.

Pete Fucile
(Signature of Registrant)

Subscribed and sworn to before me this 25 day of July, 1958.

My commission expires _____

Julius A. Suter
(Notary Public)

(SEAL)

CERTIFICATE OF REGISTRATION

STATE OF OREGON

County of Marion } ss.

This is to certify that the foregoing Registration Statement was received in the office of the State Engineer on the 28th day of July, 1958, at 8:00 o'clock A.M. and has been duly recorded in said office in Book No. 16 of Registration Statements on page GR-3972

Witness my hand this 15th day of February, 1960

Laura A. Stanley
(State Engineer)

By _____ (Deputy)

#15.00