

Registration Statement

OF CLAIMANT OF RIGHT TO APPROPRIATE GROUND WATER

TO THE STATE ENGINEER OF OREGON:

I, HARVEY S. AND ERMA E. COMMONS

of RT. 3, BOX 742, ALBANY County of LINN

State of OREGON, do hereby make application for a certificate of registration as evidence of a right to appropriate ground water.

1. Source from which water is withdrawn is DUMP WELL
(Flowing well, pump well, infiltration trench, or tunnel)

2. Location is: 4 MILES WEST OF ALBANY, ORE.
(Approximate distance and direction from nearest city or town)

and is more particularly described as follows:

(a) N. 17° E. 1340' FROM THE NE CORNER OF HENRY WATSON D.S. 61
(Give distance and bearing to corner of section or other legal subdivision)

being within NW 1/4 OF S.W. 1/4 of Sec. 22 Twp. 11S., Rge. 4W.
(Smallest legal subdivision) (N. or S.) (E. or W.)

or (b) within limits of recorded platted property, town or city:

in Lot _____, Block _____ of _____
(Name of plat or addition)

County of LINN
(If within city or town, give name)

3. Construction Work was begun on 1948; was completed on 1948
(Date) (Date)

and the ground water claimed was first used for the purposes set out below on JULY 1948
(Date)

since which time the water has been used CONTINUOUSLY
(Continuously or intermittently)

from JULY 1948 to PRESENT TIME
(Date) (Date)

4. Quantity of water claimed and used is 30 gallons per minute; 18.0 acre feet per year.

5. Purpose or Purposes for which water is used IRRIGATION AND DOMESTIC

(Domestic, irrigation, municipal, manufacturing, industrial, etc.)

6. Description of Well: Depth 48 feet, Type DRILLED
(Dug or drilled)

diameter 5 inches. Elevation of ground at well site 225 feet, mean sea level.
(As near as known)

Depth to water table 20 feet.

7. Capacity of Well: _____ g.p.m. with _____ feet drawdown.

_____ g.p.m. with _____ feet drawdown.

Date of test N.O.T. TESTED.

If Flowing Well: Measured discharge _____ g.p.m. on _____
(Date)

Shut-in pressure at ground surface _____ lbs. per sq. in. on _____
(Date)

Water is controlled by _____
(Cap, Valve, etc.)

If log of well is not available, give name and address of driller. SCHAEFFER, PHILM.M.A.M.

ORE

11. Infiltration Trench: Covered or open

Dimensions: Length ft. Minimum depth ft. Maximum depth ft.

Bottom width ft. Discharge g.p.m. Date of test

12. Tunnel: Type of lining

Dimensions:
(Length, course, and cross sectional size)

Position of water bearing stratum with reference to portal of tunnel

Log of tunnel: (Preceding table for log of well may be used, if desired. Give footage from portal and character of materials, as pertinent.)

13. Pumping Equipment:

(a) Pump MONTGOMERY WARD JET Capacity 30 g.p.m.
(Make, type and size)


(b) Motor 2 H.P. ELECTRIC
(Type and horsepower)

14. Location of area irrigated or to be irrigated, or place of use if for purposes other than irrigation.

Township North or South	Range E. or W. of Willamette Meridian	Section	Forty-acre Tract	Number Acres To Be Irrigated	Date of Reclamation
<u>11S</u>	<u>4W</u>	<u>22</u>	<u>NW 1/4 OF SW 1/4</u>	<u>5.0</u>	<u>July 1978</u>
<u>11S</u>	<u>4W</u>	<u>22</u>	<u>SW 1/4 OF SW 1/4</u>	<u>1.0</u>	<u>" "</u>
				<u>6.0</u>	

15. If the ground water supply is supplemental to an existing water supply, identification of any application for a permit, permit, certificate or adjudicated right to appropriate water made or held by the registrant.

Township 11 S Range 4 W, W.M.
North

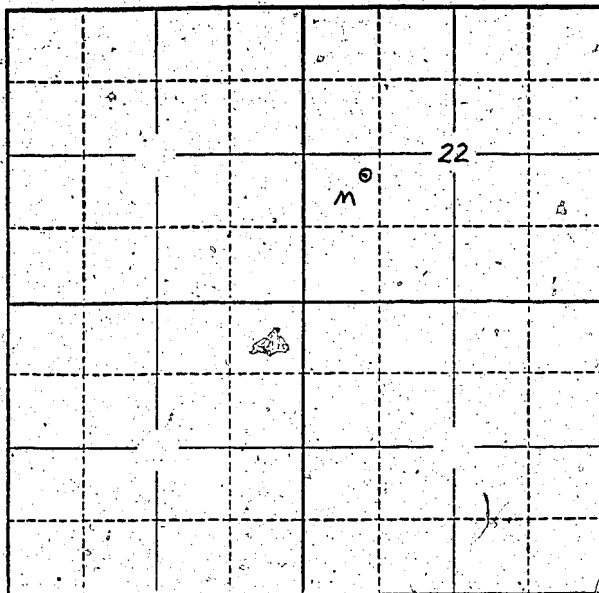

Locate well and acreage of irrigated land on plat.
Scale: 2" = 1 Mile

STATE OF OREGON

County of Lincoln } ss.

I, HARVEY S. AND ERMA E. COMMONS, being first duly sworn, do hereby certify that I have read the foregoing Registration Statement and that all of the items therein contained are true to the best of my knowledge and belief.

Harvey S. Commons Erma E. Commons
(Signature of Registrant)

Subscribed and sworn to before me this 23 day of July, 1958

My commission expires 2, 1959
(Notary Public)

(SEAL)

CERTIFICATE OF REGISTRATION

STATE OF OREGON

County of Marion } ss.

This is to certify that the foregoing Registration Statement was received in the office of the State Engineer on the 28th day of July, 1958, at 8.00 o'clock A.M. and has been duly recorded in said office in Book No. 11 of Registration Statements on page GR-2681

Witness my hand this 25th day of May, 1959

Dwight A. Stanley
(State Engineer)

By _____
(Deputy)

\$15.00