RECEIVED
NOV 1 1956
STATE ENGINEER
SALEM, OREGON

REGISTRATION NO. GR-286

Registration Statement CERTIFICATE NO. GR-275

OF CLAIMANT OF RIGHT TO APPROPRIATE GROUND WATER

(Under Chapter 708, Oregon Laws 1955.)

TO THE STATE ENGINEER OF OREGON:

I, Bruce Brahs,

of Corvallis County of Benton

State of Oregon, do hereby make application for a certificate of registration as evidence of a right to appropriate ground water.

1. **Source** from which water is withdrawn is pump well (Flowing well, pump well, infiltration trench, or tunnel)

2. **Location** is: 7½ miles S. and 3 miles W. of Corvallis (Approximate distance and direction from nearest city or town)

and is more particularly described as follows:

(a) 5.46 chains N. and 23.474 chains N. 89 degrees 36 min W. of NW cor. D.L.C.#41 (Give distance and bearing to corner of section or other legal subdivision)

being within NW1/4 of NW1/4 (Smallest legal subdivision) of Sec. 8, Twp. 13S (N. or S.), Rge. 5W (E. or W.)

or (b) within limits of recorded platted property, town or city:

in Lot ....., Block ..... of ..... (Name of plat or addition)

..... (If within city or town, give name) County of .....

3. **Construction Work** was begun on ~~unknown~~ 1920 ? (Date); was completed on 1920 ? (Date)

and the ground water claimed was first used for the purposes set out below on probably prior to 1920 (Date),

since which time the water has been used continuous (Continuously or intermittently)

from prior to 1920 (Date) to 1955 (Date).

4. **Quantity** of water claimed and used is 16 gallons per minute; 6 acre feet per year.

5. **Purpose or Purposes** for which water is used irrigation (Domestic, irrigation, municipal, manufacturing, industrial, etc.)

6. **Description of Well:** Depth 28 feet. Type drilled (Dug or drilled)

diameter 8 inches. Elevation of ground at well site 250 (As near as known) feet, mean sea level.

Depth to water table 14 feet.

7. **Capacity of Well:** unknown g.p.m. with ..... feet drawdown.

..... g.p.m. with ..... feet drawdown.

Date of test .....

If Flowing Well: Measured discharge ..... g.p.m. on ..... (Date)

Shut-in pressure at ground surface ..... lbs. per sq. in. on ..... (Date)

Water is controlled by ..... (Cap, valve, etc.)

8. **Casing:** (Give diameter, commercial specifications and depth below ground surface of each casing size.)

8 inch diameter from 0 to unknown feet

..... inch diameter from ..... to ..... feet

..... inch diameter from ..... to ..... feet

..... inch diameter from ..... to ..... feet

Describe and show depth of shoe, plug, adapter, liner or other details: unknown

9. **Perforated Casings or Screens:**

unknown from ..... to .....
(Number per foot and size of perforations, or describe screen)

..... from ..... to .....

..... from ..... to .....

..... from ..... to .....

10. **Log of Well:** (Describe each stratum or formation clearly, indicate if water bearing, and give thickness and depth as indicated.)

MATERIAL	Thickness (Feet)	Depth to Bottom (Feet)
unknown		

GR-275 A

If log of well is not available, give name and address of driller. unknown

11. **Infiltration Trench:** Covered or open .....

Dimensions: Length ..... ft. Minimum depth ..... ft. Maximum depth ..... ft.

Bottom width ..... ft. Discharge ..... g.p.m. Date of test .....

12. **Tunnel:** Type of lining .....

Dimensions: .....
(Length, course, and cross sectional size)

Position of water bearing stratum with reference to portal of tunnel .....

Log of tunnel: (Preceding table for log of well may be used, if desired. Give footage from portal and character of materials, as pertinent.)

13. **Pumping Equipment:**

(a) Pump being re-installed ..... Capacity ..... g.p.m.
(Make, type and size)

(b) Motor .....
(Type and horsepower)

14. Location of area irrigated or to be irrigated, or place of use if for purposes other than irrigation.

Township North or South	Range E. or W. of Willamette Meridian	Section	Forty-acre Tract	Number Acres To Be Irrigated	Date of Reclamation
13S	5W	8	NW1/4 of NW1/4	1.2	unknown

15. If the ground water supply is supplemental to an existing water supply, identification of any application for a permit, permit, certificate or adjudicated right to appropriate water made or held by the registrant.

.....

.....

GR-275B

Township 13S Range 5W, W.M.

North

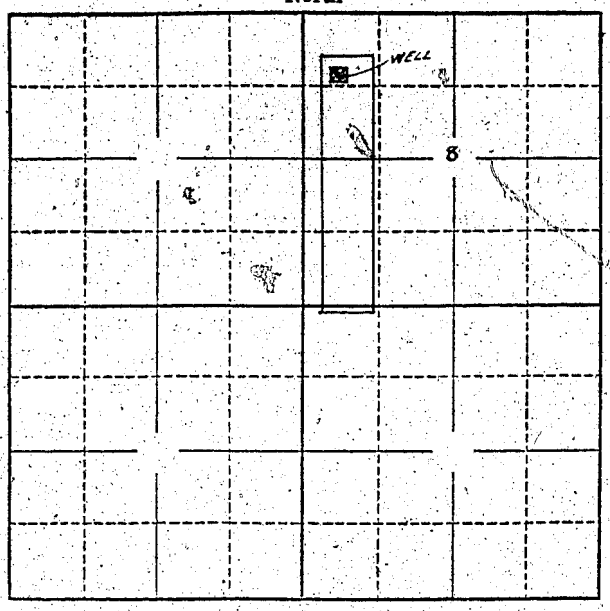

Locate well and acreage of irrigated land on plat.

Scale: 2" = 1 Mile

STATE OF OREGON
County of Benton } ss.

I, Bruce Brooks, being first duly sworn, do hereby certify that I have read the foregoing Registration Statement and that all of the items therein contained are true to the best of my knowledge and belief.

Bruce Brooks
(Signature of Registrant)

Subscribed and sworn to before me this 30 day of October, 1956

My commission expires 11-24-57 Cecil Banks
(Notary Public)

(SEAL)

CERTIFICATE OF REGISTRATION

STATE OF OREGON
County of Marion } ss.

This is to certify that the foregoing Registration Statement was received in the office of the State Engineer on the 1st day of November, 1956, at 4 o'clock A. M. and has been duly recorded in said office in Book No. 2 of Registration Statements on page GR-275-C.

~~Certificate shall be complied by [illegible] and the statement completed and applied to [illegible] by [illegible]~~

Witness my hand this 15th day of January, 1957.

Lewis A. Stanley
(State Engineer)

By .....
(Deputy)

GR-275C