

Registration Statement

OF CLAIMANT OF RIGHT TO APPROPRIATE GROUND WATER

TO THE STATE ENGINEER OF OREGON:

I, BERYL B. BABLEY
of R.T. 1, BOX 215, RICK REATH County of POLK

State of OREGON, do hereby make application for a certificate of registration as evidence of a right to appropriate ground water.

1. Source from which water is withdrawn is PUMP WELL
(Flowing well, pump well, infiltration trench, or tunnel)

2. Location is: 7 MILES S.E. OF AMITY
(Approximate distance and direction from nearest city or town)

and is more particularly described as follows:

(a) 92.5' E. & 26' S. FROM THE S.W. COR. OF AMOS HARVEY
(Give distance and bearing to corner of section or other legal subdivision) D.L.C. No. 44
being within LOT 6 (S.W. 1/4 SE 1/4) of Sec. 21, Twp. T6S, Rge. R4W
(Smallest legal subdivision) (N. or S.) (E. or W.)

or (b) within limits of recorded platted property, town or city: _____

in Lot _____, Block _____ of _____
(Name of plat or addition)

County of POLK
(If within city or town, give name)

3. Construction Work was begun on 4-1947; was completed on 4-1947
(Date) (Date)

and the ground water claimed was first used for the purposes set out below on 6-1948
(Date)

since which time the water has been used INTERMITTENTLY
(Continuously or intermittently)

from 6-1948 to 8-3-1958
(Date) (Date)

4. Quantity of water claimed and used is 120 gallons per minute; _____ acre feet per year.

5. Purpose or Purposes for which water is used IRRIGATION

(Domestic, irrigation, municipal, manufacturing, industrial, etc.)

6. Description of Well: Depth 60' feet. Type DRILLED
(Dug or drilled)

diameter 6" inches. Elevation of ground at well site 192' feet, mean sea level.
(As near as known)

Depth to water table 0' feet.

7. Capacity of Well: 120 g.p.m. with ? feet drawdown. UNKNOWN

_____ g.p.m. with _____ feet drawdown.


Date of test 4-1947

If Flowing Well: Measured discharge _____ g.p.m. on _____
(Date)

Shut-in pressure at ground surface _____ lbs. per sq. in. on _____
(Date)

Water is controlled by _____
(Cap, valve, etc.)

Township T.6 S Range R.4 W, W.M.
North

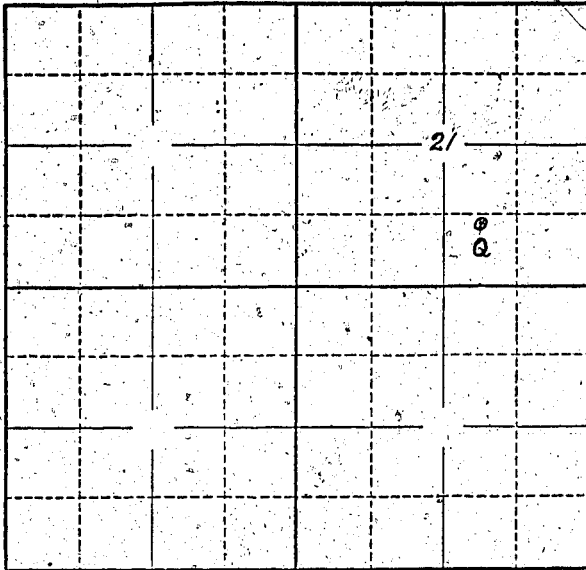

Locate well and acreage of irrigated land on plat.
Scale: 2" = 1 Mile

STATE OF OREGON

County of Marion } ss.

I, Beryl & Bagley, being first duly sworn, do hereby certify that I have read the foregoing Registration Statement and that all of the items therein contained are true to the best of my knowledge and belief.

Beryl & Bagley
(Signature of Registrant)

Subscribed and sworn to before me this 28th day of July, 19 58

My commission expires 12th June 1961 W.W.S. Bartholomew
(Notary Public)

(SEAL)

CERTIFICATE OF REGISTRATION

STATE OF OREGON

County of Marion } ss.

This is to certify that the foregoing Registration Statement was received in the office of the State Engineer on the 28th day of July, 19 58, at 2:00 o'clock P. M. and has been duly recorded in said office in Book No. 12 of Registration Statements on page GR-2701

Witness my hand this 25th day of May, 19 59

Laura A. Stanley
(State Engineer)

By _____
(Deputy)

\$15.00

GR - 2701