

Registration Statement

OF CLAIMANT OF RIGHT TO APPROPRIATE GROUND WATER

TO THE STATE ENGINEER OF OREGON:

I, Enos and Mildred Noah

of 425 N. Clover Ridge Road, Albany County of Linn
(Mailing address)

State of Oregon, do hereby make application for a certificate of registration as evidence of a right to appropriate ground water.

1. Source from which water is withdrawn is pump well
(Flowing well, pump well, infiltration trench, or tunnel)

2. Location is: 3 1/2 miles NE of Albany, Oregon
(Approximate distance and direction from nearest city or town)

and is more particularly described as follows:

(a) S. 45° 30' W. - 18.2 chains from NE corner of BLC 38, T 10 and 11 S, R 3W
(Give distance and bearing to corner of section or other legal subdivision)

being within NW 1/4 of NE 1/4 of Sec. 3, Twp. 11S, Rge. 3W
(Smallest legal subdivision) (N. or S.) (E. or W.)

or (b) within limits of recorded platted property, town or city:

in Lot _____, Block _____ of _____
(Name of plat or addition)
County of Linn
(If within city or town, give name)

3. Construction Work was begun on May, 1954; was completed on May, 1954
(Date) (Date)

and the ground water claimed was first used for the purposes set out below on June, 1954
(Date)

since which time the water has been used continuously
(Continuously or intermittently)

from June, 1954 to present time
(Date) (Date)

4. Quantity of water claimed and used is 70 gallons per minute; 53.7 acre feet per year.

5. Purpose or Purposes for which water is used Irrigation

(Domestic, irrigation, municipal, manufacturing, industrial, etc.)

6. Description of Well: Depth 91 feet. Type Drilled
(Dug or drilled)

diameter 3 inches. Elevation of ground at well site 220 feet, mean sea level.
(As near as known)

Depth to water table 4 feet.

7. Capacity of Well: 100 g.p.m. with 63 feet drawdown.
_____ g.p.m. with _____ feet drawdown.

Date of test Estimated - not tested


If Flowing Well: Measured discharge _____ g.p.m. on _____
(Date)

Shut-in pressure at ground surface _____ lbs. per sq. in. on _____
(Date)

Water is controlled by _____
(Cap, valve, etc.)

Township 11 S Range 3W, W.M.

North

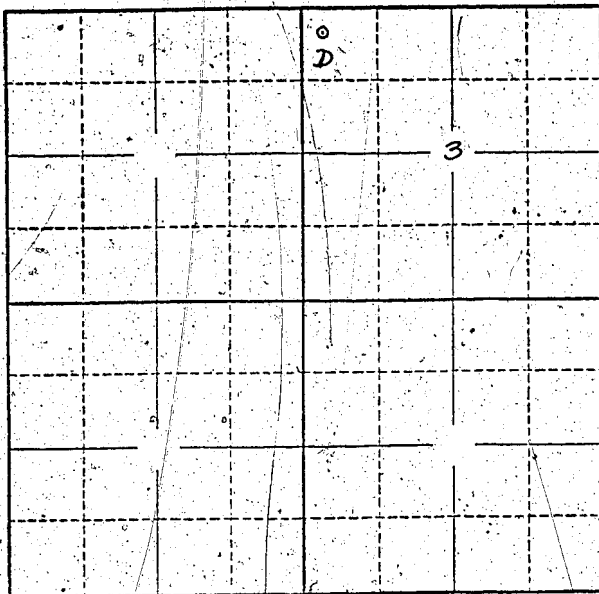

Locate well and acreage of irrigated land on plat.

Scale: 2" = 1 Mile

STATE OF OREGON

County of Linn

ss.

I, Enos and Mildred Noah, being first duly sworn, do hereby certify that I have read the foregoing Registration Statement and that all of the items therein contained are true to the best of my knowledge and belief.

Enos and Mildred Noah
(Signature of Registrant)

Subscribed and sworn to before me this 17th day of July, 1957

My commission expires 12/31/58

Harold Carpenter
(Notary Public)

(SEAL)

CERTIFICATE OF REGISTRATION

STATE OF OREGON

County of Marion

ss.

This is to certify that the foregoing Registration Statement was received in the office of the State Engineer on the 28th day of July, 1957, at 8:00 o'clock A.M. and has been duly recorded in said office in Book No. 12 of Registration Statements on page GR-2707

Witness my hand this 25th day of May, 1959

Walter A. Hines
(State Engineer)

By _____ (Deputy)

\$15.00

GR-2707