

RECEIVED  
NOV 1956  
STATE ENGINEER  
SALEM OREGON

REGISTRATION NO. GR-288  
CERTIFICATE NO. GR-261

### Registration Statement

#### OF CLAIMANT OF RIGHT TO APPROPRIATE GROUND WATER

(Under Chapter 708, Oregon Laws 1955.)

TO THE STATE ENGINEER OF OREGON:

I, Mick J. Nelke RT 1, Box 732 Salem, Ore.

of \_\_\_\_\_ County of Polk

State of Oregon, do hereby make application for a certificate of registration as evidence of a right to appropriate ground water.

1. Source from which water is withdrawn is Pump well  
(Flowing well, pump well, infiltration trench, or tunnel)

2. Location is: Approx 6 miles NW of Salem, Oregon  
(Approximate distance and direction from nearest city or town)

and is more particularly described as follows:

(a) 100 feet north and 500 feet west from SE corner of section 30.  
(Give distance and bearing to corner of section or other legal subdivision)

being within SE 1/4 of SE 1/4 of Sec. 30, Twp. 6S, Rge. 3W  
(Smallest legal subdivision) (N. or S.) (E. or W.)

or (b) within limits of recorded platted property, town or city: \_\_\_\_\_

in Lot \_\_\_\_\_, Block \_\_\_\_\_ of \_\_\_\_\_  
(Name of plat or addition)

County of \_\_\_\_\_  
(If within city or town, give name)

3. Construction Work was begun on April 1952; was completed on April 1952  
(Date) (Date)

and the ground water claimed was first used for the purposes set out below on April 1952  
(Date)

since which time the water has been used continuously during season  
(Continuously or Intermittently)

from April 1952 to Oct. 1956  
(Date) (Date)

4. Quantity of water claimed and used is 300 gallons per minute; \_\_\_\_\_ acre feet per year.

5. Purpose or Purposes for which water is used irrigation  
(Domestic, irrigation, municipal, manufacturing, industrial, etc.)

6. Description of Well: Depth 77 feet. Type Drilled  
(Dug or drilled)

diameter 8 inches. Elevation of ground at well site 172 feet, mean sea level.  
(As near as known)

Depth to water table 52.6 feet. summer

7. Capacity of Well: 250 g.p.m. with 49 feet drawdown.

350 g.p.m. with 70 feet drawdown.

Date of test 5-4-1952

If Flowing Well: Measured discharge \_\_\_\_\_ g.p.m. on \_\_\_\_\_  
(Date)

Shut-in pressure at ground surface \_\_\_\_\_ lbs. per sq. in. on \_\_\_\_\_  
(Date)

Water is controlled by \_\_\_\_\_  
(Cap, valve, etc.)

8. Casing: (Give diameter, commercial specifications and depth below ground surface of each casing size.)

8 inch diameter *steel casing* from 0 to 77<sup>6</sup> feet  
..... inch diameter ..... from ..... to ..... feet  
..... inch diameter ..... from ..... to ..... feet  
..... inch diameter ..... from ..... to ..... feet

Describe and show depth of shoe, plug, adapter, liner or other details: .....

9. Perforated Casings or Screens:

..... from 42 to 77  
(Number per foot and size of perforations, or describe screen)  
..... from ..... to .....  
..... from ..... to .....  
..... from ..... to .....

10. Log of Well: (Describe each stratum or formation clearly, indicate if water bearing, and give thickness and depth as indicated.)

MATERIAL	Thickness (Feet)	Depth to Bottom (Feet)
<i>From 53 to 77 - water bearing formation</i>	<i>24</i>	<i>77</i>

If log of well is not available, give name and address of driller. Wilcox Drilling

11. Infiltration Trench: Covered or open

Dimensions: Length \_\_\_\_\_ ft. Minimum depth \_\_\_\_\_ ft. Maximum depth \_\_\_\_\_ ft.

Bottom width \_\_\_\_\_ ft. Discharge \_\_\_\_\_ g.p.m. Date of test \_\_\_\_\_

12. Tunnel: Type of lining

Dimensions: \_\_\_\_\_  
(Length, course, and cross sectional size)

Position of water bearing stratum with reference to portal of tunnel \_\_\_\_\_

Log of tunnel: (Preceding table for log of well may be used, if desired. Give footage from portal and character of materials, as pertinent.)

13. Pumping Equipment:

(a) Pump Berkeley Turbine Capacity 300 g.p.m.  
(Make, type and size)


(b) Motor 1.5 HP.  
(Type and horsepower)

14. Location of area irrigated or to be irrigated, or place of use if for purposes other than irrigation.

Township North or South	Range E. or W. of Willamette Meridian	Section	Forty-acre Tract	Number Acres To Be Irrigated	Date of Reclamation
T6S	R3W	30	SE 1/4 of SE 1/4	20	April 1952
"	"	30	NE 1/4 of SE 1/4	7	"
"	"	29	NW 1/4 of SW 1/4	3	"
"	"	29	SW 1/4 of SW 1/4	5	"
				35	

15. If the ground water supply is supplemental to an existing water supply, identification of any application for a permit, permit, certificate or adjudicated right to appropriate water made or held by the registrant.

Township 6 S Range 3 W, W.M.  
North

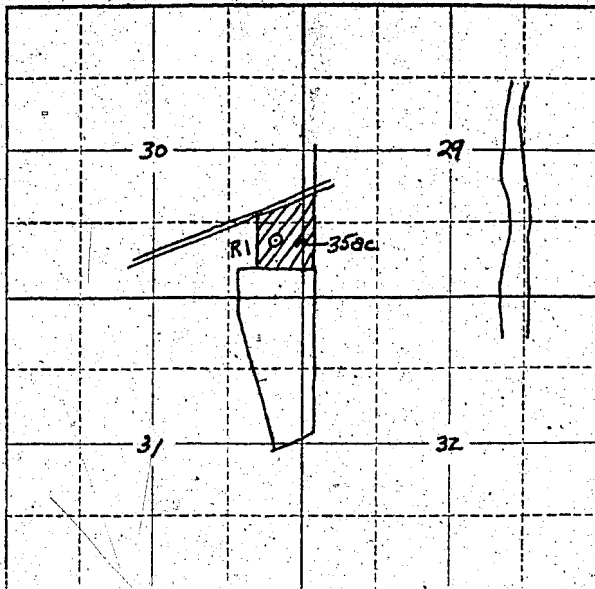

Locate well and acreage of irrigated land on plat.

Scale: 2" = 1 Mile

STATE OF OREGON

County of Marion } ss.

I, Nick J. Neelke, being first duly sworn, do hereby certify that I have read the foregoing Registration Statement and that all of the items therein contained are true to the best of my knowledge and belief.

Nick J. Neelke  
(Signature of Registrant)

Subscribed and sworn to before me this 1st day of November, 1956.

My commission expires 9/27/58  
Jeanie Baxter  
(Notary Public)

(SEAL)

### CERTIFICATE OF REGISTRATION

STATE OF OREGON

County of Marion } ss.

This is to certify that the foregoing Registration Statement was received in the office of the State Engineer on the 5th day of November, 1956, at 8 o'clock A.M. and has been duly recorded in said office in Book No. 2 of Registration Statements on page GR-261-C.

~~Construction shall be completed by x-x-x-x-x-x-x-x-19-x-x and the water completely applied to the field by x-x-x-x-x-x-x-x-19-x-x.~~

Witness my hand this 15th day of January, 1957.

Lewis A. Stanley  
(State Engineer)

By \_\_\_\_\_ (Deputy)

GR-261 C