REGISTRATION NO. GR-2884

CERTIFICATE NO. GR-2713

Registration Statement

OF CLAIMANT OF RIGHT TO APPROPRIATE GROUND WATER

(Under Chapter 708, Oregon Laws 1955.)

TO THE STATE ENGINEER OF OREGON:

I, Harold C.Walling, DBA Walling Sand & Gravel Co.,

of Salem County of Marion

State of Oregon, do hereby make application for a certificate of registration as evidence of a right to appropriate ground water.

1. **Source** from which water is withdrawn is Pump Well #2
(Flowing well, pump well, infiltration trench, or tunnel)

2. **Location** is: Approx. 100 ft. S & 100 ft. W. of the N.E.Corner of lot #16 Garden Home Tract
(Approximate distance and direction from nearest city or town)
¼ mile S.city limits of Salem, Ore.

and is more particularly described as follows:

(a) About 1500 feet north & 100 feet east from SW corner Section 35
(Give distance and bearing to corner of section or other legal subdivision)

being within NW¼ of SW¼ of Sec. 35, Twp. 7S (N. or S.), Rge. 3W (E. or W.)
(Smallest legal subdivision)

or (b) within limits of recorded platted property, town or city:

in Lot 16, Block of Subdivision of Garden Home Tracts
(Name of plat or addition)

(If within city or town, give name) County of Marion

3. **Construction Work** was begun on 1954 (Date); was completed on 1954 (Date)

and the ground water claimed was first used for the purposes set out below on 1954 (Date),

since which time the water has been used Continouusly
(Continuously or intermittently)

from 1954 (Date) to 1958 (Date)

4. **Quantity** of water claimed and used is 25 gallons per minute; acre feet per year.

5. **Purpose or Purposes** for which water is used Industrial
(Domestic, irrigation, municipal, manufacturing, industrial, etc.)

6. **Description of Well:** Depth 50 feet. Type Drilled (Dug or drilled)

diameter 8" inches. Elevation of ground at well site 150 (As near as known) feet, mean sea level.

Depth to water table 10 (April) feet.

7. **Capacity of Well:** g.p.m. with feet drawdown.

g.p.m. with feet drawdown.

Date of test

If Flowing Well: Measured discharge g.p.m. on (Date)

Shut-in pressure at ground surface lbs. per sq. in. on (Date)

Water is controlled by (Cap, valve, etc.)

8. **Casing:** (Give diameter, commercial specifications and depth below ground surface of each casing size.)

8 inch diameter from Surface to 50 feet

inch diameter from to feet

inch diameter from to feet

inch diameter from to feet

Describe and show depth of shoe, plug, adapter, liner or other details:

9. **Perforated Casings or Screens:**

from to

(Number per foot and size of perforations, or describe screen)

from to

from to

from to

10. **Log of Well:** (Describe each stratum or formation clearly, indicate if water bearing, and give thickness and depth as indicated.)

MATERIAL	Thickness (Feet)	Depth to Bottom (Feet)

GR-2713

If log of well is not available, give name and address of driller. Duffleid Bros.

11. **Infiltration Trench:** Covered or open

Dimensions: Length ft. Minimum depth ft. Maximum depth ft.

Bottom width ft. Discharge g.p.m. Date of test

12. **Tunnel:** Type of lining

Dimensions: (Length, course, and cross sectional size)

Position of water bearing stratum with reference to portal of tunnel

Log of tunnel: (Preceding table for log of well may be used, if desired. Give footage from portal and character of materials, as pertinent.)

13. **Pumping Equipment:**

(a) Pump 2" (Make, type and size) Capacity 25 g.p.m.

(b) Motor 2HP Electric (Type and horsepower)

14. Location of area irrigated or to be irrigated, or place of use if for purposes other than irrigation.

Township North or South	Range E. or W. of Willamette Meridian	Section	Forty-acre Tract	Number Acres To Be Irrigated	Date of Reclamation
7S	3W	35	NW¼ of SW¼	Industrial	1954

15. If the ground water supply is supplemental to an existing water supply, identification of any application for a permit, permit, certificate or adjudicated right to appropriate water made or held by the registrant.

GR-2713

Township 7 S Range 3 W, W.M.

North

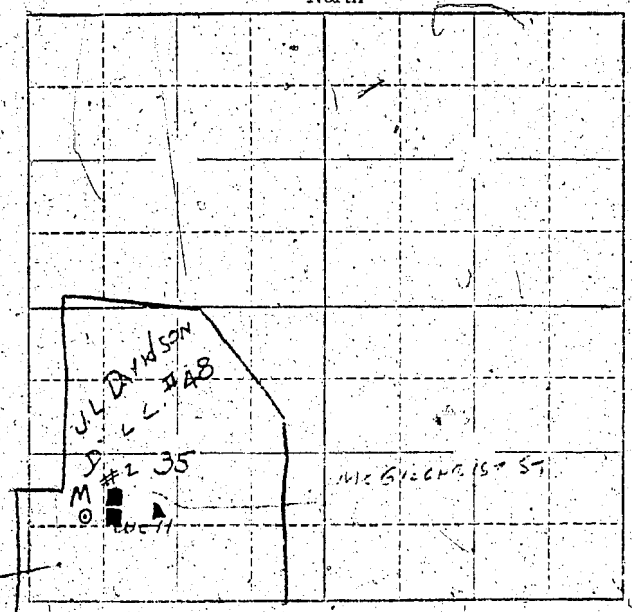

Locate well and acreage of irrigated land on plat.

Scale: 2" = 1 Mile

STATE OF OREGON }
County of Marion } ss.

I, Harold G. Walling, being first duly sworn, do hereby certify that I have read the foregoing Registration Statement and that all of the items therein contained are true to the best of my knowledge and belief.

Harold G. Walling
(Signature of Registrant)

Subscribed and sworn to before me this 25 day of May, 19 59

My commission expires Sept 1 [illegible]
(Notary Public) for Oregon

(SEAL)

CERTIFICATE OF REGISTRATION

STATE OF OREGON }
County of Marion } ss.

This is to certify that the foregoing Registration Statement was received in the office of the State Engineer on the ..... day of ....., 19....., at ..... o'clock ..... M. and has been duly recorded in said office in Book No. 12 of Registration Statements on page GR-2713

~~Construction shall be completed by ..... and the water completely applied to beneficial use by ..... 19.....~~

Witness my hand this 25th day of May, 19 59.

..... (State Engineer)

20.00

By ..... (Deputy)

GR-2713