

Registration Statement

OF CLAIMANT OF RIGHT TO APPROPRIATE GROUND WATER

TO THE STATE ENGINEER OF OREGON:

I, John R. Buchanan Lucy R. Buchanan
of R. 2 Box 158 Monmouth Oregon County of Marion
(Mailing address)

State of Oregon, do hereby make application for a certificate of registration as evidence of a right to appropriate ground water.

1. Source from which water is withdrawn is Pump Well
(Flowing well, pump well, infiltration trench, or tunnel)

2. Location is: 4 mi North Salem 1/2 mi North 1/2 mi East of Keizer
(Approximate distance and direction from nearest city or town)

and is more particularly described as follows:

(a) North 703' & West 705' of the South 4 S. Cor. sec. 35
(Give distance and bearing to corner of section or other legal subdivision)

being within the SE 1/4 SW 1/4 of Sec. 35, Twp. 6 S, Rge. 3 W
(Smallest legal subdivision) (N. or S.) (E. or W.)

or (b) within limits of recorded platted property, town or city: Salem, Ore.

in Lot 5, Block — of Clogget Fruit & Garden Tracts
(Name of plat or addition)

County of Marion
(If within city or town, give name)

3. Construction Work was begun on Oct 1953; was completed on Oct 1953
(Date) (Date)

and the ground water claimed was first used for the purposes set out below on July 1954,
(Date)

since which time the water has been used _____
(Continuously or intermittently)

from May to Sept
(Date) (Date)

4. Quantity of water claimed and used is 5, 4 1/2 gal 1/2 gallons per minute; _____ acre feet per year.

5. Purpose or Purposes for which water is used Irrigation
(Domestic, irrigation, municipal, manufacturing, industrial, etc.)

6. Description of Well: Depth 52 feet. Type Drilled
(Dug or drilled)

diameter 6 in inches. Elevation of ground at well site _____ feet, mean sea level.
(As near as known)

Depth to water table 14 feet.

7. Capacity of Well: No test g.p.m. with _____ feet drawdown.

_____ g.p.m. with _____ feet drawdown.

Date of test _____


If Flowing Well: Measured discharge _____ g.p.m. on _____
(Date)

Shut-in pressure at ground surface _____ lbs. per sq. in. on _____
(Date)

Water is controlled by _____
(Cap. valve, etc.)

Township 6 S Range 3 W, W.M.

North

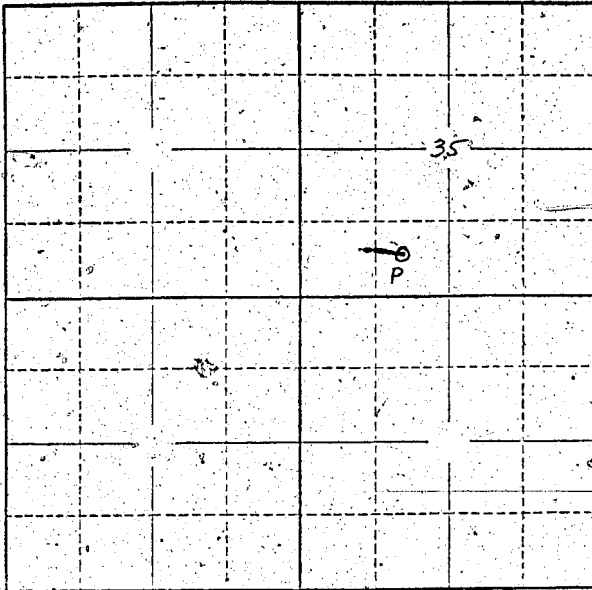

Locate well and acreage of irrigated land on plat.

Scale: 2" = 1 Mile

STATE OF OREGON

County of Marion ss.

I, John R. Buchanan Lucy R. Buchanan, being first duly sworn, do hereby certify that I have read the foregoing Registration Statement and that all of the items therein contained are true to the best of my knowledge and belief.

John R. Buchanan Lucy R. Buchanan
(Signature of Registrant)

Subscribed and sworn to before me this 28th day of July, 1958

My commission expires 12th June 1961 Wm. S. Bartholomew
(Notary Public)

(SEAL)

CERTIFICATE OF REGISTRATION

STATE OF OREGON

County of Marion } ss.

This is to certify that the foregoing Registration Statement was received in the office of the State Engineer on the 28th day of July, 1958, at 2:30 o'clock P. M. and has been duly recorded in said office in Book No. 12 of Registration Statements on page GR-2716.

Witness my hand this 25th day of May, 1959

(State Engineer)

By _____ (Deputy)

GR-2716

\$15.00