

RECEIVED
JUL 16 1956
STATE ENGINEER
SALEM, OREGON

REGISTRATION NO. GR-289
CERTIFICATE NO. GR-262

Registration Statement

OF CLAIMANT OF RIGHT, TO APPROPRIATE GROUND WATER

(Under Chapter 708, Oregon Laws 1955.)

TO THE STATE ENGINEER OF OREGON:

I, A. B. Baird Rte. 2 Box 535
of Roseburg County of Douglas

State of Oregon, do hereby make application for a certificate of registration as evidence of a right to appropriate ground water.

1. Source from which water is withdrawn is Pump well
(Flowing well, pump well, infiltration trench, or tunnel)

2. Location is: 7 mi. NW Roseburg Ore.
(Approximate distance and direction from nearest city or town)

and is more particularly described as follows: ~~8 1/2 mi. NW Roseburg Ore.~~ N. 45° W. 800 ft.

(a) ~~From S. 1/4 cor. sec. 32~~ From S. 1/4 cor. sec. 32
(Give distance and bearing to corner of section or other legal subdivision)

10 @ being within SE 1/4 of SW 1/4 Pt. 4075 N. Curry Estate of Sec. 32, Twp. 26 S, Rge. 6 W.
(Smallest legal subdivision) (N. or S.) (E. or W.)

or (b) within limits of recorded platted property, town or city:

in Lots 4 & 5, Block NONE of N. CURRY Estate
(Name of plat or addition)

County of Douglas
(If within city or town, give name)

3. Construction Work was begun on 1952; was completed on 1952
(Date) (Date)

and the ground water claimed was first used for the purposes set out below on 1952
(Date)

since which time the water has been used continuously during season
(Continuously or intermittently)

from JUNE 1 to OCT 1
(Date) (Date)

4. Quantity of water claimed and used is 94 gallons per minute; _____ acre feet per year.

5. Purpose or Purposes for which water is used Berries and Garden

Irrigation
(Domestic, irrigation, municipal, manufacturing, industrial, etc.)

6. Description of Well: Depth 22 feet. Type _____
(Dug or drilled)

diameter 40 inches. Elevation of ground at well site 400 feet, mean sea level.
(As near as known)

Depth to water table 20 feet.

7. Capacity of Well: 94 g.p.m. with 3' feet drawdown.

80 g.p.m. with 4' feet drawdown.

Date of test 1954

If Flowing Well: Measured discharge _____ g.p.m. on _____
(Date)

Shut-in pressure at ground surface _____ lbs. per sq. in. on _____
(Date)

Water is controlled by _____
(Cap, valve, etc.)

8. Casing: (Give diameter, commercial specifications and depth below ground surface of each casing size.)

..... inch diameter *No record* from to feet
 inch diameter from to feet
 inch diameter from to feet
 inch diameter from to feet

Describe and show depth of shoe, plug, adapter, liner or other details:

.....

.....

9. Perforated Casings or Screens:

..... *No record* from to
(Number per foot and size of perforations, or describe screen)
 from to
 from to
 from to

10. Log of Well: (Describe each stratum or formation clearly, indicate if water bearing, and give thickness and depth as indicated.)

MATERIAL	Thickness (Feet)	Depth to Bottom (Feet)
<i>No record</i>		

If log of well is not available, give name and address of driller.

11. Infiltration Trench: Covered or open

Dimensions: Length ft. Minimum depth ft. Maximum depth ft.

Bottom width ft. Discharge g.p.m. Date of test

12. Tunnel: Type of lining

Dimensions:
(Length, course, and cross sectional size)

Position of water bearing stratum with reference to portal of tunnel

Log of tunnel: (Preceding table for log of well may be used, if desired. Give footage from portal and character of materials, as pertinent.)

13. Pumping Equipment:

(a) Pump Pacific - centrifugal Capacity 2 1/2 100 g.p.m.
(Make, type and size)


(b) Motor Electric - 5 H.P.
(Type and horsepower)

14. Location of area irrigated or to be irrigated, or place of use if for purposes other than irrigation.

Township North or South	Range E. or W. of Willamette Meridian	Section	Forty-acre Tract	Number Acres To Be Irrigated	Date of Reclamation
T26S	R6W	32	SE 1/4 of SW 1/4	8	1952

15. If the ground water supply is supplemental to an existing water supply, identification of any application for a permit, permit, certificate or adjudicated right to appropriate water made or held by the registrant.

Township 26s Range 6W, W.M.
North

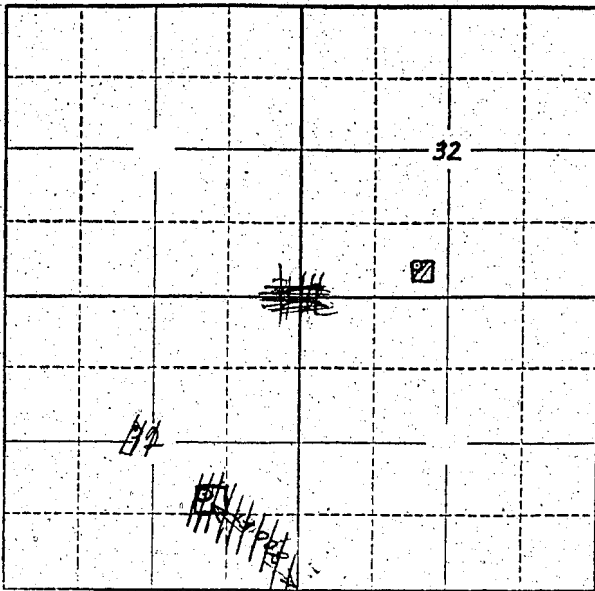

Locate well and acreage of irrigated land on plat.
Scale: 2" = 1 Mile

STATE OF OREGON

County of Douglas } ss.

I, A. B. Baird, being first duly sworn, do hereby certify that I have read the foregoing Registration Statement and that all of the items therein contained are true to the best of my knowledge and belief.

A. B. Baird
(Signature of Registrant)

Subscribed and sworn to before me this 27 day of June, 1958

My commission expires

Charles C. Warner
(Notary Public)
County Clerk

(SEAL)

CERTIFICATE OF REGISTRATION

STATE OF OREGON

County of Marion } ss.

This is to certify that the foregoing Registration Statement was received in the office of the State Engineer on the 5th day of November, 1956, at 8 o'clock A.M. and has been duly recorded in said office in Book No. 2 of Registration Statements on page GR-262-C.

~~Construction should be completed by x-x-x-x-x-x-x-x-x-x-1957 and the water completely applied to x-x~~

Witness my hand this 15th day of January, 1957

Lewis A. Stanley
(State Engineer)

By