

# Registration Statement

## OF CLAIMANT OF RIGHT TO APPROPRIATE GROUND WATER

TO THE STATE ENGINEER OF OREGON:

I, Mr. Mrs. Herman Meyer

of Jefferson County of Madison

State of Oregon do hereby make application for a certificate of registration as evidence of a right to appropriate ground water.

1. Source from which water is withdrawn is Well # 2  
(Flowing well, pump well, infiltration trench, or tunnel)

2. Location is: Approx. 2 mi. S.E. Jefferson  
(Approximate distance and direction from nearest city or town)

and is more particularly described as follows:

(a) 470' west and 3800' North to N.W. cor. Sec. 18  
(Give distance and bearing to corner of section or other legal subdivision)

being within N.W. 1/4 of S.W. 1/4 of Sec. 18, Twp. 10 S, Rge. 2 W  
(Smallest legal subdivision) (N or S) (E or W)

or (b) within limits of recorded platted property, town or city:

in Lot \_\_\_\_\_, Block \_\_\_\_\_ of \_\_\_\_\_  
(Name of plat or addition)

County of \_\_\_\_\_  
(If within city or town, give name)

3. Construction Work was begun on 1952; was completed on 1952  
(Date) (Date)

and the ground water claimed was first used for the purposes set out below on April 1952  
(Date)

since which time the water has been used Continuously  
(Continuously or Intermittently)

from April 1952 to Aug. 1952  
(Date) (Date)

4. Quantity of water claimed and used is 256 gallons per minute; 2 acre feet per year.

5. Purpose or Purposes for which water is used Irrigation  
(Domestic, irrigation, municipal, manufacturing, industrial, etc.)

6. Description of Well: Depth 52 feet. Type drilled  
(Dug or drilled)

diameter 8 inches. Elevation of ground at well site \_\_\_\_\_ feet, mean sea level.  
(As near as known)

Depth to water table 20 feet.

7. Capacity of Well: 256 g.p.m. with 5 feet drawdown.  
\_\_\_\_\_ g.p.m. with \_\_\_\_\_ feet drawdown.

Date of test Estimated by # Sprinklers used of Max. Irrigation x Sprinkler disch. rate (32 x 8)

If Flowing Well: Measured discharge \_\_\_\_\_ g.p.m. on \_\_\_\_\_  
(Date)


Shut-in pressure at ground surface \_\_\_\_\_ lbs. per sq. in. on \_\_\_\_\_  
(Date)

Water is controlled by \_\_\_\_\_  
(Cap, valve, etc.)





Township 10S Range 2W, W.M.  
North

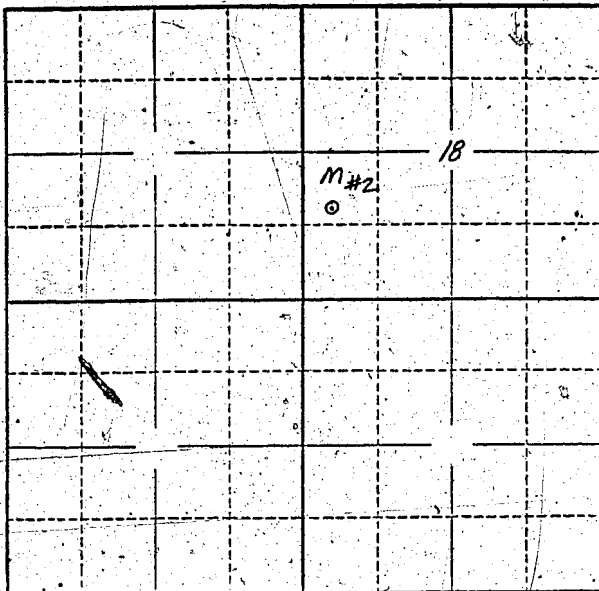

Map in file GR-2892

Locate well and acreage of irrigated land on plat.  
Scale: 2" = 1 Mile

STATE OF OREGON

County of Marion } ss.

I, Therman Kasper, being first duly sworn, do hereby certify that I have read the foregoing Registration Statement and that all of the items therein contained are true to the best of my knowledge and belief.

Therman Kasper  
(Signature of Registrant)

Subscribed and sworn to before me this 28th day of July, 1958.

My commission expires 12th June 1961 Wm. S. Bartholmeus  
(Notary Public)

(SEAL)

**CERTIFICATE OF REGISTRATION**

STATE OF OREGON

County of Marion } ss.

This is to certify that the foregoing Registration Statement was received in the office of the State Engineer on the 28th day of July, 1958, at 3:30 o'clock P. M. and has been duly recorded in said office in Book No. 12 of Registration Statements on page GR-2722

Witness my hand this 25th day of May, 1959

Leura A. Stanley  
(State Engineer)

By \_\_\_\_\_  
(Deputy)

#15.00

GR-2722