

Registration Statement

OF CLAIMANT OF RIGHT TO APPROPRIATE GROUND WATER

TO THE STATE ENGINEER OF OREGON:

I, Robert L. Skelton

of 3940 Nash Road, Corvallis

(Mailing address)

County of Benton

State of Oregon

, do hereby make application for a certificate of registration as evidence of a right to appropriate ground water.

1. Source from which water is withdrawn is Pump well

(Flowing well, pump well, infiltration trench, or tunnel)

2. Location is: 3 miles southwest city center of Corvallis

(Approximate distance and direction from nearest city or town)

and is more particularly described as follows:

(a) S. 89° 58' W 2837.77 feet and S 0° 07' E 1014.71 feet from the southwest corner of the James A. Bennett (Give distance and bearing to corner of section or other legal subdivision) D. L. C. 745 being within

(Smallest legal subdivision)

of Sec. 9

Twp. 12 S.

Rge. 5 E.

(N. or S.)

(E. or W.)

or (b) within limits of recorded platted property, town or city:

in Lot _____, Block _____ of _____

(Name of plat or addition)

(If within city or town, give name)

County of Benton

3. Construction Work was begun on 8/10/53

(Date)

; was completed on 9/10/53

(Date)

and the ground water claimed was first used for the purposes set out below on 9/10/53

(Date)

since which time the water has been used

Intermittently

(Continuously or intermittently)

from June 1

(Date)

to Sept. 30

(Date)

(Depending on weather)

4. Quantity of water claimed and used is 40 gallons per minute; _____ acre feet per year.

5. Purpose or Purposes for which water is used

Domestic and irrigation.

(Domestic, irrigation, municipal, manufacturing, industrial, etc.)

6. Description of Well: Depth 80 feet. Type Drilled

(Dug or drilled)

diameter 8 inches.

Elevation of ground at well site 240

(As near as known)

feet, mean sea level.

Depth to water table 15 feet.

7. Capacity of Well: 40 g.p.m. with 40 feet drawdown.

_____ g.p.m. with _____ feet drawdown.

Date of test 9/13

If Flowing Well: Measured discharge _____ g.p.m. on _____

Shut-in pressure at ground surface _____ lbs. per sq. in. on _____

(Date)

Water is controlled by _____

(Date)

(Cap, valve, etc.)

8. Casing: (Give diameter, commercial specifications and depth below ground surface of each casing size.)

8 inch diameter from 0 to 70 feet
..... inch diameter from to feet
..... inch diameter from to feet
..... inch diameter from to feet

Describe and show depth of shoe, plug, adapter, liner or other details:

9. Perforated Casings or Screens:

..... from to
(Number per foot and size of perforations, or describe screen)
..... from to
..... from to
..... from to

10. Log of Well: (Describe each stratum or formation clearly, indicate if water bearing, and give thickness and depth as indicated.)

MATERIAL	Thickness (Feet)	Depth to Bottom (Feet)

If log of well is not available, give name and address of driller. Bill Howell

Rte 2, Corvallis, Oregon

11. Infiltration Trench: Covered or open _____
Dimensions: Length _____ ft. Minimum depth _____ ft. Maximum depth _____ ft.

Bottom width _____ ft. Discharge _____ g.p.m. Date of test _____

12. Tunnel: Type of lining _____

Dimensions: _____
(Length, course, and cross sectional size)

Position of water bearing stratum with reference to portal of tunnel: _____

Log of tunnel: (Preceding table for log of well may be used, if desired. Give footage from portal and character of materials, as pertinent.)

13. Pumping Equipment:

(a) Pump Downard E. D. 300, Jet Pump Capacity 50 g.p.m.
(Make, type and size)


(b) Motor Single phase, 220 volt, 3 H. P.
(Type and horsepower)

14. Location of area irrigated or to be irrigated, or place of use if for purposes other than irrigation.

Township North or South	Range E. or W. of Willametta Meridian	Section	Forty-acre Tract	Number Acres To Be Irrigated	Date of Reclamation
T 12 S	R 5 W	9	<i>SE 1/4 of SW 1/4</i>	9.91	1983

15. If the ground water supply is supplemental to an existing water supply, identification of any application for a permit, permit, certificate or adjudicated right to appropriate water made or held by the registrant.

Township 12S Range 5W, W.M.
North

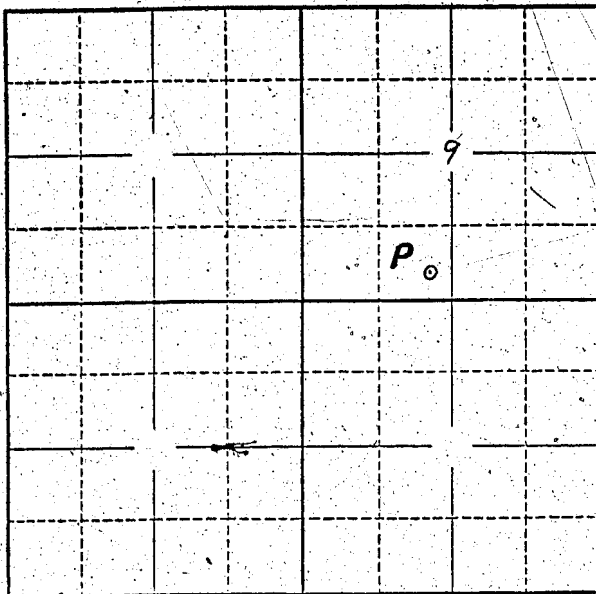

Locate well and acreage of irrigated land on plat.
Scale: 2" = 1 Mile

STATE OF OREGON

County of Columbia } ss.

I, Robert J. [Signature], being first duly sworn, do hereby certify that I have read the foregoing Registration Statement and that all of the items therein contained are true to the best of my knowledge and belief.

[Signature]
(Signature of Registrant)

Subscribed and sworn to before me this 26th day of July, 1950

My commission expires Feb 14, 1961 [Signature]
(Notary Public)

(SEAL)

CERTIFICATE OF REGISTRATION

STATE OF OREGON

County of Marion } ss.

This is to certify that the foregoing Registration Statement was received in the office of the State Engineer on the 28th day of July, 1950, at 3:30 o'clock P. M. and has been duly recorded in said office in Book No. 12 of Registration Statements on page GR-2730

Witness my hand this 25th day of May, 1959

[Signature]
(State Engineer)

By _____
(Deputy)

GR-2730

\$15.00