

Registration Statement

OF CLAIMANT OF RIGHT TO APPROPRIATE GROUND WATER

TO THE STATE ENGINEER OF OREGON:

I, John H. Deming
of 32605 Ward Cir Salem County of Mariola
(Mailing address)

State of Oregon, do hereby make application for a certificate of registration as evidence of a right to appropriate ground water.

1. Source from which water is withdrawn is flowing well
(Flowing well, pump well, infiltration trench, or tunnel)

2. Location is: 2 miles north east of Salem city limits
(Approximate distance and direction from nearest city or town)

and is more particularly described as follows:

(a) E. 20 ch. South & 6.10 ch. West N.E. corner Sec. 12
(Give distance and bearing to corner of section or other legal subdivision)

being within N.E. 1/4 of N.E. 1/4 of Sec. 12, Twp. 7 S, Rge. 3 W
(Smallest legal subdivision) (N. or S.) (E. or W.)

or (b) within limits of recorded platted property, town or city:

in Bk _____, Block _____ of _____
(Name of plat or addition)

County of Mariola
(If within city or town, give name)

3. Construction Work was begun on 4-8-37, was completed on 9-10-37
(Date) (Date)

and the ground water claimed was first used for the purposes set out below on 1938
(Date)

since which time the water has been used Intermittently
(Continuously or Intermittently)

from May to September
(Date) (Date)

4. Quantity of water claimed and used is 35 gallons per minute; _____ acre feet per year.

5. Purpose or Purposes for which water is used _____
(Domestic, irrigation, municipal, manufacturing, industrial, etc.)

6. Description of Well: Depth 67 feet. Type drilled
(Dug or drilled)

diameter _____ inches. Elevation of ground at well site _____ feet, mean sea level.
(As near as known)

Depth to water table 20 feet.

7. Capacity of Well: 50 g.p.m. with 16 feet drawdown.

_____ g.p.m. with _____ feet drawdown.

Date of test _____

If Flowing Well: Measured discharge _____ g.p.m. on _____
(Date)

Shut-in pressure at ground surface _____ lbs. per sq. in. on _____
(Date)

Water is controlled by _____
(Cap, valve, etc.)

8. Casing: (Give diameter, commercial specifications and depth below ground surface of each casing size.)

6 inch diameter Steel from 0 to 64 feet
 inch diameter from to feet
 inch diameter from to feet
 inch diameter from to feet

Describe and show depth of shoe, plug, adapter, liner or other details:


9. Perforated Casings or Screens:

(Number per foot and size of perforations, or describe screen) from to
No Perforations from to
 from to
 from to

10. Log of Well: (Describe each stratum or formation clearly, indicate if water bearing, and give thickness and depth as indicated.)

MATERIAL	Thickness (Feet)	Depth to Bottom (Feet)
Soil	3	3
Clay, yellow	21	24
Clay, blue	10	34
Sand, fine	4	38
Cemented gravel	20	58
Sand medium	5	63
Sand and gravel, water bearing	1	64

Township 7 S. Range 2 & 3 W. W.M. North

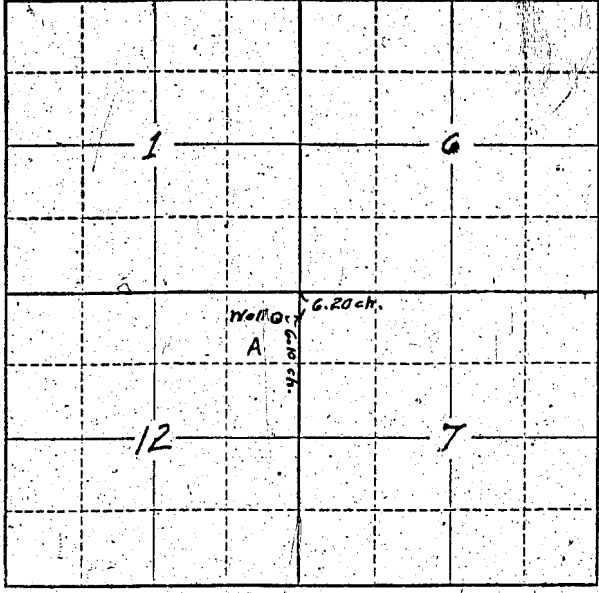

Locate well and acreage of irrigated land on plat.
Scale: 2" = 1 Mile

STATE OF OREGON }
County of Marion } ss.

I, John H Denny, being first duly sworn, do hereby certify that I have read the foregoing Registration Statement and that all of the items therein contained are true to the best of my knowledge and belief.

John H Denny
(Signature of Registrant)

Subscribed and sworn to before me this 27th day of July, 1958

My commission expires 12th June 1961
Wm. S. Bartholomew
(Notary Public)

(SEAL)

CERTIFICATE OF REGISTRATION

STATE OF OREGON }
County of Marion } ss.

This is to certify that the foregoing Registration Statement was received in the office of the State Engineer on the 28th day of July, 1958, at 4:50 o'clock P. M. and has been duly recorded in said office in Book No. 12 of Registration Statements on page GR 2732

Witness my hand this 25th day of May, 1959

Lewis A. Stanley
(State Engineer)

By _____
(Deputy)

GR - 2732

#/1500