

Registration Statement

REGISTRATION NO. GR-2905CERTIFICATE NO. GR-2734

OF CLAIMANT OF RIGHT TO APPROPRIATE GROUND WATER

(Under Chapter 708, Oregon Laws 1955.)

TO THE STATE ENGINEER OF OREGON:

I, GRANT A. BRIDGEMAN
 of SALEM RT 5 BOX 149F County of MARION
 State of OREGON, do hereby make application for a certificate of registration as evidence
 of a right to appropriate ground water.

1. Source from which water is withdrawn is PUMP WELL
(Flowing well, pump well, infiltration trench, or tunnel)

2. Location is: 1/2 MILE NORTH and 1/2 MILE WEST of AVONSVILLE
(Approximate distance and direction from nearest city or town) COUNTY OR #858

and is more particularly described as follows:

(a) 950 feet south & 870 feet west from NE corner Section 26
(Give distance and bearing to corner of section or other legal subdivision)

being within NE 1/4 of NE 1/4 of Sec. R. 6 Twp. T. 8 S. Rge. R. 2 W.
(Smallest legal subdivision) (N. or S.) (E. or W.)

or (b) within limits of recorded platted property, town or city:

in Lot _____, Block _____ of _____
(Name of plat or addition)

County of MARION
(If within city or town, give name)

3. Construction Work was begun on MAY 1955; was completed on JUNE 1955
(Date) (Date)

and the ground water claimed was first used for the purposes set out below on JUNE 1955
(Date)

since which time the water has been used intermittently during season
(Continuously or intermittently)

from JUNE 1955 to Oct. 1957
(Date) (Date)

4. Quantity of water claimed and used is 184 gallons per minute; _____ acre
 feet per year.

5. Purpose or Purposes for which water is used IRRIGATION + HOME

(Domestic, irrigation, municipal, manufacturing, industrial, etc.)

6. Description of Well: Depth 101 feet. Type DRILLED
(Dug or drilled)

diameter 8 inches. Elevation of ground at well site _____ feet, mean sea level.
(As near as known)

Depth to water table 9 feet. July 28-1958

7. Capacity of Well: 350 g.p.m. with 47 feet drawdown. 1 foot drop from 46' to 47' after 18 hrs of pumping.

_____ g.p.m. with _____ feet drawdown.

Date of test JUNE 1955

If Flowing Well: Measured discharge _____ g.p.m. on _____
(Date)

Shut-in pressure at ground surface _____ lbs. per sq. in. on _____
(Date)

Water is controlled by _____
(Cap, valve, etc.)

8. Casing: (Give diameter, commercial specifications and depth below ground surface of each casing size.)

8 inch diameter STEEL CASING from 0 to 44 feet
 inch diameter DRILLED IN ROCK from 44 to 101 feet
 inch diameter from to feet
 inch diameter from to feet

Describe and show depth of shoe, plug, adapter, liner or other details:

9. Perforated Casings or Screens:

None from to
 (Number per foot and size of perforations, or describe screen)
 from to
 from to
 from to

10. Log of Well: (Describe each stratum or formation clearly, indicate if water bearing, and give thickness and depth as indicated.)

MATERIAL	Thickness (Feet)	Depth to Bottom (Feet)
gravels	0	44
rock, black basalt	44	101
water bearing at 96 feet & 78 ft.		

If log of well is not available, give name and address of driller. MARTIN WEST
4120 MARKET ST. SALEM ORE.

11. Infiltration Trench: Covered or open
 Dimensions: Length ft. Minimum depth ft. Maximum depth ft.
 Bottom width ft. Discharge g.p.m. Date of test

12. Tunnel: Type of lining
 Dimensions:
(Length, course, and cross sectional size)
 Position of water bearing stratum with reference to portal of tunnel

Log of tunnel: (Preceding table for log of well may be used, if desired. Give footage from portal and character of materials, as pertinent.)


13. Pumping Equipment: *set to 70 feet.*
 (a) Pump F.M. TURBINE Capacity 190 g.p.m.
(Make, type and size)
 (b) Motor F.M. 10 HP. 3P. INDUCTION
(Type and horsepower)

14. Location of area irrigated or to be irrigated, or place of use if for purposes other than irrigation.

Township North or South	Range E. or W. of Willamette Meridian	Section	Forty-acre Tract	Number Acres To Be Irrigated	Date of Reclamation
<u>T8S</u>	<u>R2W</u>	<u>26</u>	<u>NE¹/₄ & NE¹/₄</u>	<u>24.5</u>	<u>1955</u>
<u>"</u>	<u>"</u>	<u>"</u>	<u>NW¹/₄ of NE¹/₄</u>	<u>1.5</u>	<u>"</u>
				<u>26.0</u>	

15. If the ground water supply is supplemental to an existing water supply, identification of any application for a permit, permit, certificate or adjudicated right to appropriate water made or held by the registrant.

Township 8-S Range 2-W W.M.
North

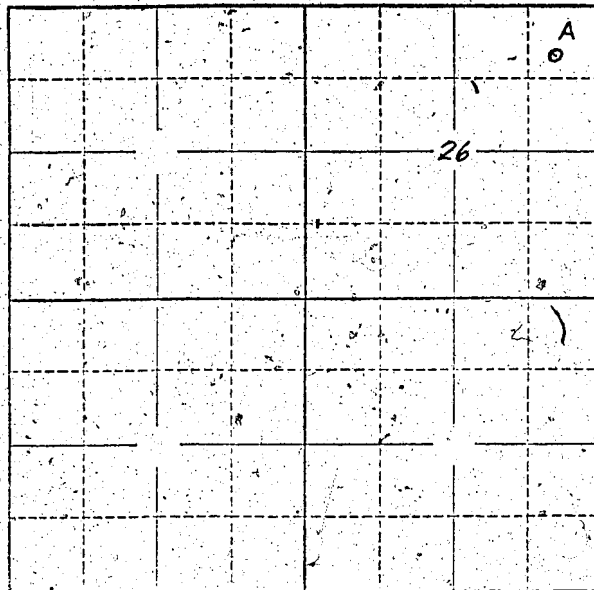

Locate well and acreage of irrigated land on plat.
Scale: 2" = 1 Mile

STATE OF OREGON

County of Marion } ss.

I, Edward E. Erickson, being first duly sworn, do hereby certify that I have read the foregoing Registration Statement and that all of the items therein contained are true to the best of my knowledge and belief.

Edward E. Erickson
(Signature of Registrant)

Subscribed and sworn to before me this 29th day of July, 1958

My commission expires 12th June 1961

Wm. S. Bar F. Lewis
(Notary Public)

(SEAL)

CERTIFICATE OF REGISTRATION

STATE OF OREGON

County of Marion } ss.

This is to certify that the foregoing Registration Statement was received in the office of the State Engineer on the 29th day of July, 1958, at 8:45 o'clock A. M. and has been duly recorded in said office in Book No. 12 of Registration Statements on page GR-2734


Witness my hand this 25th day of May, 1959

Wm. S. Bar F. Lewis
(State Engineer)

By _____ (Deputy)

GR-2734

\$15.00