

Registration Statement

OF CLAIMANT OF RIGHT TO APPROPRIATE GROUND WATER

TO THE STATE ENGINEER OF OREGON:

I, Maurice Hynes
of Route 2, Box 197 Silverton County of Marion
(Mailing address)

State of _____, do hereby make application for a certificate of registration as evidence of a right to appropriate ground water.

- 1. Source from which water is withdrawn is Pump Well
(Flowing well, pump well, infiltration trench, or tunnel)
- 2. Location is: 6 miles west of Silverton, Oregon
(Approximate distance and direction from nearest city or town)

and is more particularly described as follows:

(a) 560 ft. North & 345 ft. east from W 1/4 corner Section 36
(Give distance and bearing to corner of section or other legal subdivision)
being within SW 1/4 or NW 1/4 of Sec. 36, Twp. 6 S, Rge. 2 W
(Smallest legal subdivision) (N. or S.) (E. or W.)

or (b) within limits of recorded platted property, town or city:
in Lot _____ Block _____ of _____
(Name of plat or addition)

County of Marion
(If within city or town, give name)

3. Construction Work was begun on March 10, 1937; was completed on March 12, 1937
(Date) (Date)

and the ground water claimed was first used for the purposes set out below on About July 1, 1950
(Date)

since which time the water has been used Intermittently
(Continuously or intermittently)

from July 1937 to July 1958
(Date) (Date)

4. Quantity of water claimed and used is 55 gallons per minute; _____ acre feet per year.

5. Purpose or Purposes for which water is used For water supply for Turkeys
until 1940 After 1950 it has been ~~used~~ used for irrigation
(Domestic, irrigation, municipal, manufacturing, industrial, etc.)

6. Description of Well: Depth 112 feet. Type Drilled
(Dug or drilled)
diameter 6 inches. Elevation of ground at well site 197 feet, mean sea level.
(As near as known)

Depth to water table 60 feet.

7. Capacity of Well: 55 g.p.m. with 10 feet drawdown.
_____ g.p.m. with _____ feet drawdown.

Date of test _____

If Flowing Well: Measured discharge _____ g.p.m. on _____
(Date)

Shut-in pressure at ground surface _____ lbs. per sq. in. on _____
(Date)

Water is controlled by _____
(Cap, valve, etc.)

8. Casing: (Give diameter, commercial specifications and depth below ground surface of each casing size.)

6 inch diameter from 0 to 112 feet
 inch diameter from to feet
 inch diameter from to feet
 inch diameter from to feet

Describe and show depth of shoe, plug, adapter, liner or other details:

.....

9. Perforated Casings or Screens:

6 per foot Size not Known from 102 to 112
(Number per foot and size of perforations, or describe screen)
 from to
 from to
 from to

10. Log of Well: (Describe each stratum or formation clearly, indicate if water bearing, and give thickness and depth as indicated.)

MATERIAL	Thickness (Feet)	Depth to Bottom (Feet)
Not known but think first rock was reached at about 95ft		

If log of well is not available, give name and address of driller.

J. A. Sneed + Sons

2505 Brooks St.

Salem, Oregon

11. Infiltration Trench: Covered or open

Dimensions: Length ft. Minimum depth ft. Maximum depth ft.

Bottom width ft. Discharge g.p.m. Date of test

12. Tunnel: Type of lining

Dimensions: (Length, course, and cross sectional size)

Position of water bearing stratum with reference to portal of tunnel

Log of tunnel: (Preceding table for log of well may be used, if desired. Give footage from portal and character of materials, as pertinent.)

13. Pumping Equipment:

(a) Pump Peerless Hi Lift Capacity 55 g.p.m.
(Make, type and size)


(b) Motor Wisconsin Gas 20 H.P.
(Type and horsepower)

14. Location of area irrigated or to be irrigated, or place of use if for purposes other than irrigation.

Township North or South	Range E. or W. of Williams' Meridian	Section	Forty-acre Tract	Number Acres To Be Irrigated	Date of Reclamation
T6S	R2W	36	SE 1/4 • NW 1/4	11.0	1950

15. If the ground water supply is supplemental to an existing water supply, identification of any application for a permit, permit, certificate or adjudicated right to appropriate water made or held by the registrant.

Township 6S Range 2W, W.M.
North

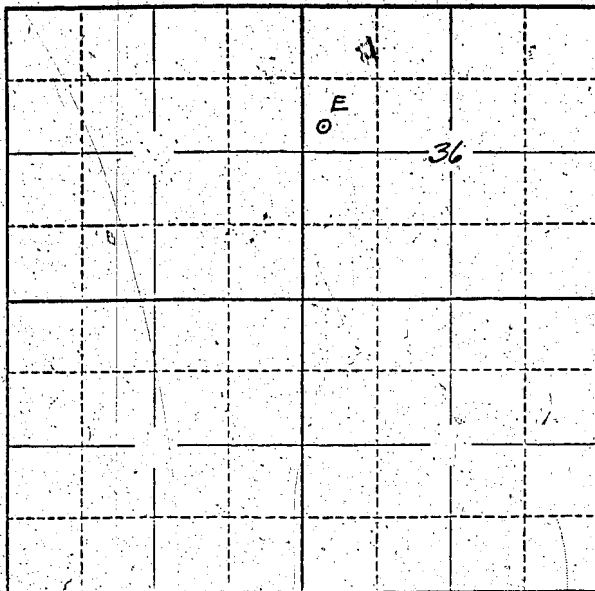

Locate well and acreage of irrigated land on plat.
Scale: 2" = 1 Mile

STATE OF OREGON

County of Marion

} ss.

I, _____, being first duly sworn, do hereby certify that I have read the foregoing Registration Statement and that all of the items therein contained are true to the best of my knowledge and belief.

Maurice Hynes
(Signature of Registrant)

Subscribed and sworn to before me this 29th day of July, 1958.

My commission expires 12th June 1961

Wm. S. Bartholomew
(Notary Public)

(SEAL)

CERTIFICATE OF REGISTRATION

STATE OF OREGON

County of Marion

} ss.

This is to certify that the foregoing Registration Statement was received in the office of the State Engineer on the 29th day of July, 1958, at 9:30 o'clock A. M. and has been duly recorded in said office in Book No. 12 of Registration Statements on page GR-2737

Witness my hand this 25th day of May, 1959

Wm. A. Stanley
(State Engineer)

By _____

(Deputy)

GR 2737

#1500