

Registration Statement

OF CLAIMANT OF RIGHT TO APPROPRIATE GROUND WATER

TO THE STATE ENGINEER OF OREGON:

I, CRESTVIEW FARMS

of RT. 3, Box 362, Mohamha County of CLACKAMAS

State of OREGON, do hereby make application for a certificate of registration as evidence of a right to appropriate ground water.

1. Source from which water is withdrawn is Pump Well
(Flowing well, pump well, infiltration trench, or tunnel)

2. Location is: 3 1/4 miles West & 1 1/2 miles S. of Mohamha;
(Approximate distance and direction from nearest city or town)

and is more particularly described as follows:

(a) S 48°W, 3145' FROM NE CORNER OF SEC. 23;
(Give distance and bearing to corner of section or other legal subdivision)

being within SW 1/4 NE 1/4 of Sec. 23, Twp. 5S, Rge. 1E
(Smallest legal subdivision) (N. or S.) (E. or W.)

or (b) within limits of recorded platted property, town or city:

in Lot _____, Block _____ of _____
(Name of plat or addition)

County of _____
(If within city or town, give name)

3. Construction Work was begun on June 1954; was completed on July 1954
(Date) (Date)

and the ground water claimed was first used for the purposes set out below on August 1954
(Date)

since which time the water has been used Continuously
(Continuously or intermittently)

from August 1954 to 1958
(Date) (Date)

4. Quantity of water claimed and used is 60 gallons per minute; _____ acre feet per year.

(Domestic, irrigation, municipal, manufacturing, industrial, etc.)

6. Description of Well: Depth 219 feet. Type Drilled
(Dug or drilled)

diameter 6 inches. Elevation of ground at well site 235 feet, mean sea level.
(As near as known)

Depth to water table 40 feet.

7. Capacity of Well: 60 g.p.m. with 150 feet drawdown.

_____ g.p.m. with _____ feet drawdown.


Date of test July 1954

If Flowing Well: Measured discharge _____ g.p.m. on _____
(Date)

Shut-in pressure at ground surface _____ lbs. per sq. in. on _____
(Date)

Water is controlled by _____
(Cap, valve, etc.)

Township 55 Range 10, W.M.
North

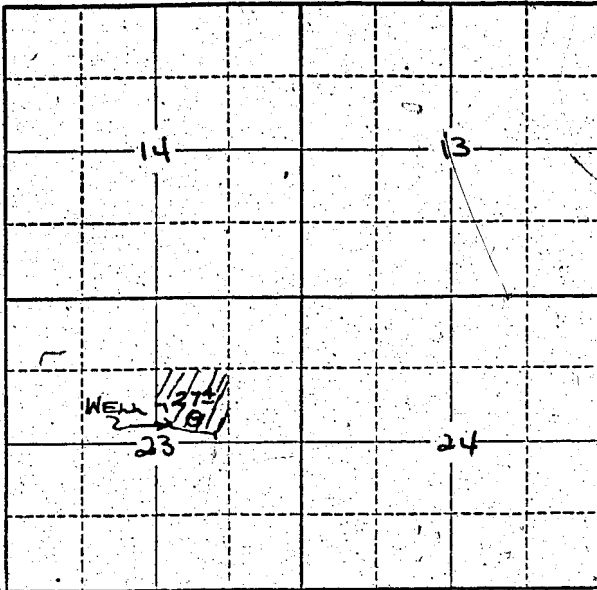

Locate well and acreage of irrigated land on plat.
Scale: 2" = 1 Mile

STATE OF OREGON

County of CLATSOP } ss.

I, Charlie F. Lucht, being first duly sworn, do hereby certify that I have read the foregoing Registration Statement and that all of the items therein contained are true to the best of my knowledge and belief.

Charlie F. Lucht
(Signature of Registrant)

Subscribed and sworn to before me this 28th day of July, 1958.

My commission expires 2/25/59
George H. Wells
(Notary Public)

(SEAL)

CERTIFICATE OF REGISTRATION

STATE OF OREGON

County of Marion } ss.

This is to certify that the foregoing Registration Statement was received in the office of the State Engineer on the 29th day of July, 1958, at 9:30 o'clock A. M. and has been duly recorded in said office in Book No. 12 of Registration Statements on page GR-2738

Witness my hand this 25th day of May, 1959.
LINDA A. STANLEY
(State Engineer)

By _____
(Deputy)

GR - 2738

\$1500