

REGISTRATION NO. GR 291

Registration Statement CERTIFICATE NO. GR-298

OF CLAIMANT OF RIGHT TO APPROPRIATE GROUND WATER

(Under Chapter 708, Oregon Laws 1955.)

TO THE STATE ENGINEER OF OREGON:

HERBERT

I, H.C. Neave & Margaret E. Neave.

of Rt. 2 Junction City County of Lane

State of Oregon do hereby make application for a certificate of registration as evidence of a right to appropriate ground water.

1. Source from which water is withdrawn is Pump well. # 1
(Flowing well, pump well, infiltration trench, or tunnel)

2. Location is: 3 miles Southeast of Junction City.
(Approximate distance and direction from nearest city or town)

and is more particularly described as follows:

(a) S.47°00'W. 652.46 feet from N.E. cor. of N.E. 1/4 of S.W. 1/4 of Sec. 10
(Give distance and bearing to corner of section or other legal subdivision)

being within N.E. 1/4 of S.W. 1/4 of Sec. 10, Twp. 16.S., Rge. 4.W.
(Smallest legal subdivision) (N. or S.) (E. or W.)

or (b) within limits of recorded platted property, town or city:

in Lot _____, Block _____ of _____
(Name of plat or addition)

County of _____
(If within city or town, give name)

3. Construction Work was begun on July 10; was completed on July 1953
(Date) (Date)

and the ground water claimed was first used for the purposes set out below on July 1953
(Date)

since which time the water has been used for irrigation when needed
(Continuously or intermittently)

from April 1 to Oct. 31
(Date) (Date)

4. Quantity of water claimed and used is 400 gallons per minute; _____ acre feet per year.

5. Purpose or Purposes for which water is used Irrigation

FARMING
(Domestic, irrigation, municipal, manufacturing, industrial, etc.)

6. Description of Well: Depth 25 feet. Type Driven
(Dug or drilled)

diameter 4 inches. Elevation of ground at well site 340 feet, mean sea level.
(As near as known)

Depth to water table 20 feet.

7. Capacity of Well: 400 g.p.m. with 25 feet drawdown.
_____ g.p.m. with _____ feet drawdown.

Date of test 1953

If Flowing Well: Measured discharge _____ g.p.m. on _____
(Date)

Shut-in pressure at ground surface _____ lbs. per sq. in. on _____
(Date)

Water is controlled by _____
(Cap, valve, etc.)

8. Casing: (Give diameter, commercial specifications and depth below ground surface of each casing size.)

4 inch diameter *driven pipe* from 0 to 25 feet
inch diameter from to feet
inch diameter from to feet
inch diameter from to feet

Describe and show depth of shoe, plug, adapter, liner or other details:

9. Perforated Casings or Screens:

no record from to
(Number per foot and size of perforations, or describe screen)
from to
from to
from to

10. Log of Well: (Describe each stratum or formation clearly, indicate if water bearing, and give thickness and depth as indicated.)

MATERIAL	Thickness (Feet)	Depth to Bottom (Feet)
Drove well untill I hit water in gravel.		
Do not know formation between top & gravel.		

If log of well is not available, give name and address of driller.

11. Infiltration Trench: Covered or open

Dimensions: Length ft. Minimum depth ft. Maximum depth ft.

Bottom width ft. Discharge g.p.m. Date of test

12. Tunnel: Type of lining

Dimensions:
(Length, course, and cross sectional size)

Position of water bearing stratum with reference to portal of tunnel

Log of tunnel: (Preceding table for log of well may be used, if desired. Give footage from portal and character of materials, as pertinent.)

13. Pumping Equipment:

(a) Pump 4" gas pump Capacity 400 g.p.m.
(Make, type and size)

(b) Motor 38 H.P. Berkley
(Type and horsepower)

14. Location of area irrigated or to be irrigated, or place of use if for purposes other than irrigation.

Township North or South	Range E. or W. of Willamette Meridian	Section	Forty-acre Tract	Number Acres To Be Irrigated	Date of Reclamation
16.S.	4.W.	10	N.E. $\frac{1}{4}$ of S.W. $\frac{1}{4}$	9.7	July 1953


Herbert C. Heave.
Vol. 195 Pg. 145

Beginning at a point on the North line of the Wm. Brice Donation Land Claim No. 50 in T.16.S. R.4.W. of the Willamette Meridian, 13.44 chains West of the Northeast corner thereof and run thence North 8.90 chains, thence West 13.44 chains, thence South 8.90 chains, thence East 13.44 chains to the place of beginning, containing 11.96 acres. Also beginning at the Northeast corner of the Wm. Brice Donation Land Claim No. 50 in said Township and Range and run thence North 8.90 chains, thence West 13.44 chains, thence South 8.90 chains, thence East 13.44 chains to the place of beginning. Containing 11.96 acres more or less in Lane County Oregon.

--	--	--	--	--	--

15. If the ground water supply is supplemental to an existing water supply, identification of any application for a permit, permit, certificate or adjudicated right to appropriate water made or held by the registrant.

Township 16.S. Range 4.W., W.M.
North

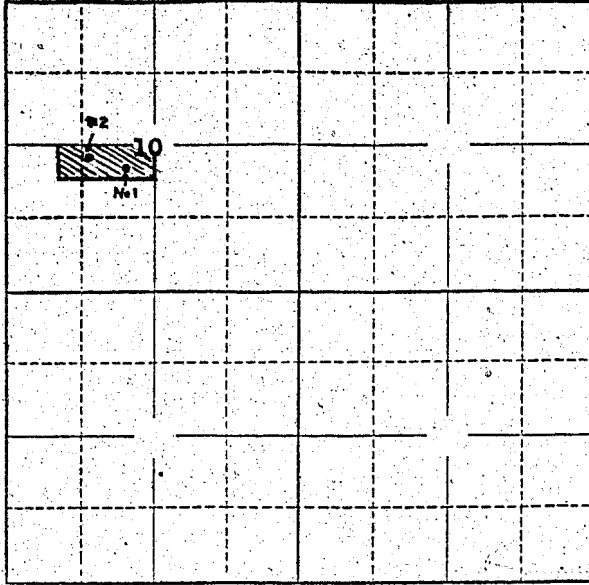

See Map
in folder
for accurate
location

Locate well and acreage of irrigated land on plat.

Scale: 2" = 1 Mile

STATE OF OREGON

County of LANE

ss.

I, HERBERT C. NEAVE & Margaret E. Neave, being first duly sworn, do hereby certify that I have read the foregoing Registration Statement and that all of the items therein contained are true to the best of my knowledge and belief.

Margaret E. Neave

Herbert C. Neave
(Signature of Registrant)

Subscribed and sworn to before me this 11th day of January, 1957.

My commission expires April 11, 1960

Helma Steubert
(Notary Public)

(SEAL)

SEE PAGE GR-298 G FOR
CERTIFICATE OF REGISTRATION

STATE OF OREGON

County of Marion

ss.

This is to certify that the foregoing Registration Statement was received in the office of the State Engineer on the 11 day of January, 1957 and has been duly recorded in said office in Book No. 18 Registration Statements on page 10

Construction shall be completed by 1957 and the water completely applied to benefit 18

Witness my hand this _____ day of _____, 19_____

(State Engineer)

By _____
(Deputy)

GR-298 C

Registration Statement CERTIFICATE NO. GR-298

OF CLAIMANT OF RIGHT TO APPROPRIATE GROUND WATER

(Under Chapter 703, Oregon Laws 1955.)

TO THE STATE ENGINEER OF OREGON:

HERBERT
I, H.C. Neave & Margaret E. Neave,

of Rt. 2 Junction City County of Lane

State of Oregon, do hereby make application for a certificate of registration as evidence of a right to appropriate ground water.

1. Source from which water is withdrawn is Pump well. #2
(Flowing well, pump well, infiltration trench, or tunnel)

2. Location is: 3 miles Southeast of Junction City.
(Approximate distance and direction from nearest city or town)

and is more particularly described as follows:

(a) S. 79° 25' W. 1288.25 feet from N.E. cor. of N.E. 1/4 of S.W. 1/4 of Sec. 10
(Give distance and bearing to corner of section or other legal subdivision)

being within N.E. 1/4 of S.W. 1/4 of Sec. 10, Twp. 16 S., Rge. 4 W.
(Smallest legal subdivision) (N. or S.) (E. or W.)

or (b) within limits of recorded platted property, town or city:

in Lot _____, Block _____ of _____
(Name of plat or addition)

County of _____
(If within city or town, give name)

3. Construction Work was begun on JUL 4, 1953, was completed on July 1953
(Date) (Date)

and the ground water claimed was first used for the purposes set out below on July 1953
(Date)

since which time the water has been used for irrigation when needed.
(Continuously or intermittently)

from April 1 to Oct 31
(Date) (Date)

4. Quantity of water claimed and used is 400 gallons per minute; _____ acre feet per year.

5. Purpose or Purposes for which water is used Irrigation
FARMING
(Domestic, irrigation, municipal, manufacturing, industrial, etc.)

6. Description of Well: Depth 25 feet. Type Driven
(Dug or drilled)

diameter 4 inches. Elevation of ground at well site 340 feet, mean sea level.
(As near as known)

Depth to water table 20 feet.

7. Capacity of Well: 400 g.p.m. with 24 feet drawdown.
_____ g.p.m. with _____ feet drawdown.

Date of test 1953

If Flowing Well: Measured discharge _____ g.p.m. on _____
(Date)

Shut-in pressure at ground surface _____ lbs. per sq. in. on _____
(Date)

Water is controlled by _____
(Cap, valve, etc.)

8. Casing: (Give diameter, commercial specifications and depth below ground surface of each casing size.)

4 inch diameter steel casing (pipe) from 0 to 25 feet
 inch diameter from to feet
 inch diameter from to feet
 inch diameter from to feet

Describe and show depth of shoe, plug, adapter, liner or other details:

9. Perforated Casings or Screens:

unknown from to
(Number per foot and size of perforations, or describe screen)
 from to
 from to
 from to

10. Log of Well: (Describe each stratum or formation clearly, indicate if water bearing, and give thickness and depth as indicated.)

MATERIAL	Thickness (Feet)	Depth to Bottom (Feet)
Drove well untill I hit water in gravel.		
Do not know formation between top and gravel.		

If log of well is not available, give name and address of driller.

11. Infiltration Trench: Covered or open

Dimensions: Length ft. Minimum depth ft. Maximum depth ft.

Bottom width ft. Discharge g.p.m. Date of test

12. Tunnel: Type of lining

Dimensions:
(Length, course, and cross sectional size)

Position of water bearing stratum with reference to portal of tunnel

Log of tunnel: (Preceding table for log of well may be used, if desired. Give footage from portal and character of materials, as pertinent.)

13. Pumping Equipment:

(a) Pump 4" GAS PUMP Capacity 400 g.p.m.
(Make, type and size)

(b) Motor 38 H.P. Barkley
(Type and horsepower)


14. Location of area irrigated or to be irrigated, or place of use if for purposes other than irrigation.

Township North or South	Range E. or W. of Willamette Meridian	Section	Forty-acre Tract	Number Acres To Be Irrigated	Date of Reclamation
16.S.	4.W.	10	N.E. 1/4 of S.W. 1/4	4.75	July 1953
			S.W. 1/4 of S.W. 1/4	5.45	" "

15. If the ground water supply is supplemental to an existing water supply, identification of any application for a permit, permit, certificate or adjudicated right to appropriate water made or held by the registrant.

GR-298 F

Township 16 S., Range 4 W., W.M.
North

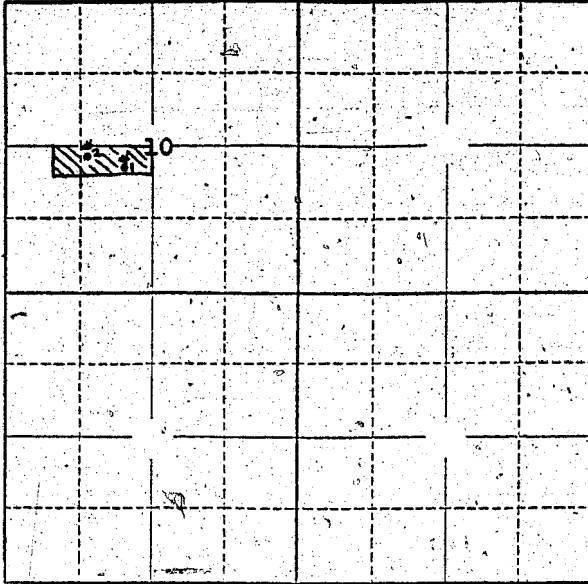

Locate well and acreage of irrigated land on plat.
Scale: 2" = 1 Mile

STATE OF OREGON

County of LANE } ss.

I, HERBERT C. NEAVE + Margaret E. Neave being first duly sworn, do hereby certify that I have read the foregoing Registration Statement and that all of the items therein contained are true to the best of my knowledge and belief.

Margaret E. Neave

Herbert C. Neave
(Signature of Registrant)

Subscribed and sworn to before me this 17th day of January, 1957.

My commission expires April 11, 1960.

John Stuebath
(Notary Public)

(SEAL)

CERTIFICATE OF REGISTRATION.

STATE OF OREGON } ss.
County of Marion

This is to certify that the foregoing Registration Statement was received in the office of the State Engineer on the 14th day of January, 1957, at 1 o'clock P.M. and has been duly recorded in said office in Book No. 2 of Registration Statements on page GR-298 G.

Construction shall be completed by x-x-x-x-x-x-x-x-x-x-x-x-x-x-x-x and the water completely applied to benificial use by x-x-x-x-x-x-x-x-x-x-x-x-x-x-x-x.

Witness my hand this 25th day of February, 1957.

Lewis A. Stanley
(State Engineer)

By _____ (Deputy)