

# Registration Statement

## OF CLAIMANT OF RIGHT TO APPROPRIATE GROUND WATER

TO THE STATE ENGINEER, OF OREGON:

I, Ms. NORA PITNEY  
of 4175 TAKMAN ST., SALEM, OREGON County of MARION  
State of OREGON do hereby make application for a certificate of registration as evidence of a right to appropriate ground water.

- Source from which water is withdrawn is Pump Well  
(Flowing well, pump well, infiltration trench, or tunnel)
- Location is: 400 FT EAST OF JUNCTION CITY LIMITS  
(Approximate distance and direction from nearest city or town)

and is more particularly described as follows:

(a) 510 feet North & 300 feet east from Center of Section 32  
(Give distance and bearing to corner of section or other legal subdivision)  
being within SW 1/4 of NE 1/4 of Sec. 32, Twp. 15S, Rge. 4W  
(Smallest legal subdivision) (N. or S.) (E. or W.)

or (b) within limits of recorded platted property, town or city  
in Lot \_\_\_\_\_ Block \_\_\_\_\_ of \_\_\_\_\_  
(Name of plat or addition)

County of \_\_\_\_\_  
(If within city or town, give name)

- Construction Work was begun on 3-15-48; was completed on 5-15-48  
(Date) (Date)

and the ground water claimed was first used for the purposes set out below on 4-15-48  
(Date)  
since which time the water has been used CONTINUOUSLY  
(Continuously or intermittently)  
from 7-15-48 to 7-20-53  
(Date) (Date)

- Quantity of water claimed and used is 150 gallons per minute; \_\_\_\_\_ acre feet per year.

- Purpose or Purposes for which water is used IRRIGATION  
(Domestic, irrigation, municipal, manufacturing, industrial, etc.)

- Description of Well: Depth 22 feet. Type DRILLED  
(Dug or drilled)  
diameter 3 inches. Elevation of ground at well site 42 feet, mean sea level.  
(As near as known)  
Depth to water table 12 feet.

- Capacity of Well: 250 g.p.m. with \_\_\_\_\_ feet drawdown.  
\_\_\_\_\_ g.p.m. with \_\_\_\_\_ feet drawdown.

Date of test 3-15-53

If Flowing Well: Measured discharge \_\_\_\_\_ g.p.m. on \_\_\_\_\_  
(Date)

Shut-in pressure at ground surface \_\_\_\_\_ lbs. per sq. in. on \_\_\_\_\_  
(Date)

Water is controlled by \_\_\_\_\_  
(Cap, valve, etc.)

8. Casing: (Give diameter, commercial specifications and depth below ground surface of each casing size.)

3 inch diameter PIPE from 0 to 22 feet  
inch diameter from to feet  
inch diameter from to feet  
inch diameter from to feet

Describe and show depth of shoe, plug, adapter, liner or other details:

9. Perforated Casings or Screens:

SAND POINT from to  
(Number per foot and size of perforations, or describe screen)  
from to  
from to  
from to

10. Log of Well: (Describe each stratum or formation clearly, indicate if water bearing, and give thickness and depth as indicated.)

MATERIAL	Thickness (Feet)	Depth to Bottom (Feet)
SAND & GRAVELS		

If log of well is not available, give name and address of driller. MELVIN R. ANDREWS  
4170 OAKMAN ST., SALEM, OREGON

11. Infiltration Trench: Covered or open \_\_\_\_\_  
 Dimensions: Length \_\_\_\_\_ ft. Minimum depth \_\_\_\_\_ ft. Maximum depth \_\_\_\_\_ ft.  
 Bottom width \_\_\_\_\_ ft. Discharge \_\_\_\_\_ g.p.m. Date of test \_\_\_\_\_

12. Tunnel: Type of lining \_\_\_\_\_  
 Dimensions: \_\_\_\_\_  
(Length, course, and cross sectional size)  
 Position of water bearing stratum with reference to portal of tunnel \_\_\_\_\_

Log of tunnel: (Preceding table for log of well may be used, if desired. Give footage from portal and character of materials, as pertinent.)


13. Pumping Equipment:  
 (a) Pump FAIRBANK HORSE CENTRIFUGAL 1 1/2" Capacity 100 g.p.m.  
(Make, type and size)  
 (b) Motor 5 HONDA VERT SINGLE PHASE ELECTRIC  
(Type and horsepower)

14. Location of area irrigated or to be irrigated, or place of use if for purposes other than irrigation.

Township North or South	Range E. or W. of Willamette Meridian	Section	Forty-acre Tract	Number Acres To Be Irrigated	Date of Reclamation
<u>T15 SOUTH</u>	<u>4-WEST</u>	<u>32</u>	<u>SW 1/4 + NE 1/4</u>	<u>15.2</u> Acres	<u>1948</u>

15. If the ground water supply is supplemental to an existing water supply, identification of any application for a permit, permit, certificate or adjudicated right to appropriate water made or held by the registrant.

Township 15S Range 4W W.M.  
North

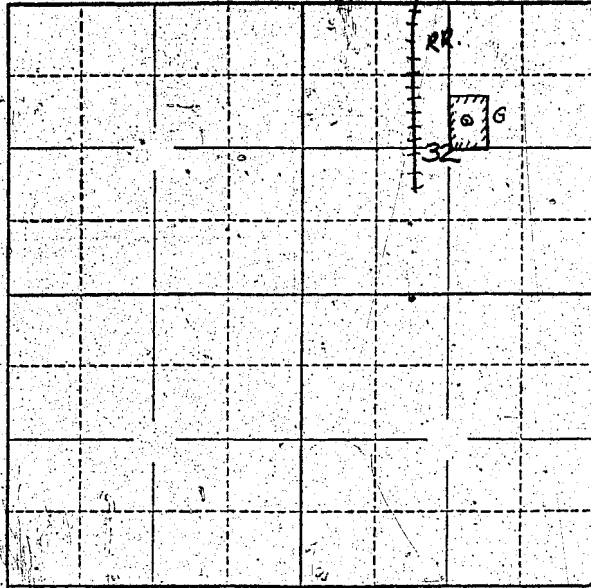

Locate well and acreage of irrigated land on plat.

Scale: 2" = 1 Mile

STATE OF OREGON

County of Marion } ss.

I, \_\_\_\_\_, being first duly sworn, do hereby certify that I have read the foregoing Registration Statement and that all of the items therein contained are true to the best of my knowledge and belief.

Andrew R. Andrews  
(Signature of Registrant)

Subscribed and sworn to before me this 29th day of July, 1958

My commission expires 12th June 1961 Wm. S. Bartholomew  
(Notary Public)

(SEAL)

**CERTIFICATE OF REGISTRATION**

STATE OF OREGON

County of Marion } ss.

This is to certify that the foregoing Registration Statement was received in the office of the State Engineer on the 29 day of July, 1958, at 10:00 o'clock A. M. and has been duly recorded in said office in Book No. 17 of Registration Statements on page GR-4072

Witness my hand this 16th day of May, 1960

Lawrence A. Stanley  
(State Engineer)

By \_\_\_\_\_ (Deputy)

\$15.00