

Registration Statement

OF CLAIMANT OF RIGHT TO APPROPRIATE GROUND WATER

TO THE STATE ENGINEER OF OREGON:

I, ROGER G. Wheeler
 of PO BOX 127, TURNER County of MARION
(Mailing address)
 State of OREGON, do hereby make application for a certificate of registration as evidence of a right to appropriate ground water.

1. Source from which water is withdrawn is Spring Sump
(Flowing well, pump well, irrigation trench, or tunnel)

2. Location is: 2 MILES EAST AND ONE HALF NORTH OF MARION
(Approximate distance and direction from nearest city or town)

and is more particularly described as follows:

(a) 490 feet West and 750 feet South from N.E. CORNER
(Give distance and bearing to corner of section or other legal subdivision)

being within N.E. 1/4 of NE 1/4 of Sec. 27, Twp. 75, Rge. 2W 27
(Smallest legal subdivision) (N. or S.) (E. or W.)

or (b) within limits of recorded platted property, town or city:

in Lot _____, Block _____ of _____
(Name of plat or addition)

County of MARION
(If within city or town, give name)

3. Construction Work was begun on 1948; was completed on 1948
(Date) (Date)

and the ground water claimed was first used for the purposes set out below on 1949
(Date)

since which time the water has been used Intermittently During Season
(Continuously or Intermittently)

from 1949 to 1958
(Date) (Date)

4. Quantity of water claimed and used is 128 gallons per minute; _____ acre feet per year.

5. Purpose or Purposes for which water is used: IRRIGATION

(Domestic, irrigation, municipal, manufacturing, industrial, etc.)

6. Description of ^{Sump} Well: Depth 16 feet. Type Dug
(Dug or drilled)

diameter _____ inches. Elevation of ground at well site 260 feet, mean sea level.
(As near as known)

Depth to water table 3 feet. Spring

7. Capacity of Well: 100 g.p.m. with 8 feet drawdown.

_____ g.p.m. with _____ feet drawdown.


Date of test JULY 15 1958

If Flowing Well: Measured discharge _____ g.p.m. on _____
(Date)

Shut-in pressure at ground surface _____ lbs. per sq. in. on _____
(Date)

Water is controlled by _____
(Cap, valve, etc.)

Township 95 Range 21 W.M.
North

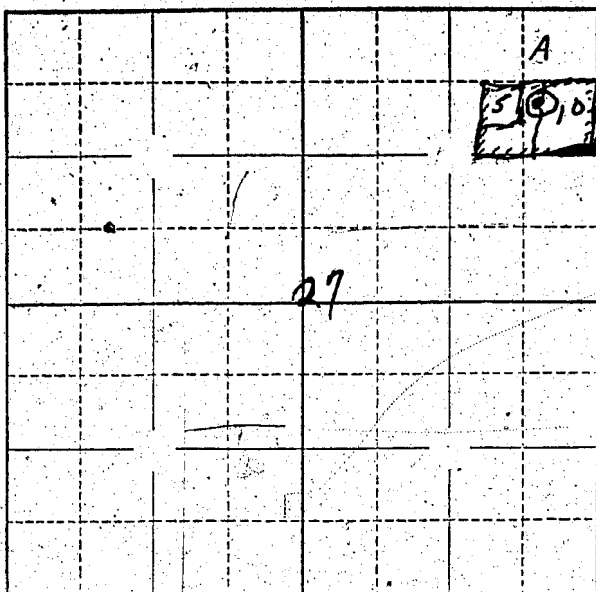

Locate well and acreage of irrigated land on plat.

Scale: $\frac{1}{4}$ " = 1 Mile

STATE OF OREGON

County of Marion } ss.

I, Roger Y. Whalen being first duly sworn, do hereby certify that I have read the foregoing Registration Statement and that all of the items therein contained are true to the best of my knowledge and belief.

Roger Y. Whalen
(Signature of Registrant)

Subscribed and sworn to before me this 29th day of July, 1958

My commission expires 12th June 1961 Wm. S. Bartholomew
(Notary Public)

(SEAL)

CERTIFICATE OF REGISTRATION

STATE OF OREGON } ss.
County of Marion

This is to certify that the foregoing Registration Statement was received in the office of the State Engineer on the 29th day of July, 1958, at 10:10 o'clock A. M. and has been duly recorded in said office in Book No. 12 of Registration Statements on page GR-2744

Witness my hand this 25th day of May, 1959

Stanley A. Stanley
(State Engineer)

By _____ (Deputy)

GR-2744

#1500a