REGISTRATION NO. GR-292

CERTIFICATE NO. GR-264

Registration Statement

OF CLAIMANT OF RIGHT TO APPROPRIATE GROUND WATER

(Under Chapter 708, Oregon Laws 1955.)

TO THE STATE ENGINEER OF OREGON:

I, W. F. Crossing,

of R. R. Box 249, Canby County of Clackamas

State of Oregon, do hereby make application for a certificate of registration as evidence of a right to appropriate ground water.

1. **Source** from which water is withdrawn is Pump well
(Flowing well, pump well, infiltration trench, or tunnel)

2. **Location** is: 3/4 mi. N of Barlow;
(Approximate distance and direction from nearest city or town)

and is more particularly described as follows:

(a) 244 Ft. E. 250 N. of S.W. Cor. Sec. 32
(Give distance and bearing to corner of section or other legal subdivision)

being within S W 1/4 of SW1/4 of Sec. 32, Twp. 3 S, Rge. 1 E
(Smallest legal subdivision) (N. or S.) (E. or W.)

or (b) within limits of recorded platted property, town or city:

in Lot, Block of
(Name of plat or addition)

(If within city or town, give name) County of

3. **Construction Work** was begun on Oct. 12 1954 (Date) was completed on Oct. 22 1954 (Date)

and the ground water claimed was first used for the purposes set out below on May 11 1955 (Date),

since which time the water has been used continuously
(Continuously or intermittently)

from May 1 1955 (Date) to Oct. 1 1956 (Date)

4. **Quantity** of water claimed and used is 115 gallons per minute; Optional acre feet per year.

5. **Purpose or Purposes** for which water is used Irrigation of Crops
(Domestic, irrigation, municipal, manufacturing, industrial, etc.)

6. **Description of Well:** Depth 79 feet, Type Drilled
(Dug or drilled)

diameter 12 inches. Elevation of ground at well site 625 (As near as known) feet, mean sea level.

Depth to water table 20 feet.

7. **Capacity of Well:** 115 g.p.m. with 6 ft 6 in. feet drawdown.

g.p.m. with feet drawdown.

Date of test Oct. 22 1954

If Flowing Well: Measured discharge g.p.m. on (Date)

Shut-in pressure at ground surface lbs. per sq. in. on (Date)

Water is controlled by
(Cap, valve, etc.)

8. **Casing:** (Give diameter, commercial specifications and depth below ground surface of each casing size.)

12 inch diameter from Surface to 40 ft feet

6 inch diameter from 40 ft to 79 ft feet

inch diameter from to feet

inch diameter from to feet

Describe and show depth of shoe, plug, adapter, liner or other details:

9. **Perforated Casings or Screens:**

Perforated (Number per foot and size of perforations, or describe screen) from 20 to 26 ft

Perforated, with gravel around outside from 54 to 77 ft

from to

from to

10. **Log of Well:** (Describe each stratum or formation clearly, indicate if water bearing, and give thickness and depth as indicated.)

MATERIAL	Thickness (Feet)	Depth to Bottom (Feet)
0-7 Surface	7	
7-28 gravel with water	21	
28-40 sandy	12	
40-66 blue clay with sandy streaks	26	
66-79 sand & gravel with lots of water	13	

GR-264 A

If log of well is not available, give name and address of driller. J. T. Miller
Aurora. Ore

11. **Infiltration Trench:** Covered or open .....

Dimensions: Length ..... ft. Minimum depth ..... ft. Maximum depth ..... ft.

Bottom width ..... ft. Discharge ..... g.p.m. Date of test .....

12. **Tunnel:** Type of lining .....

Dimensions: .....
(Length, course, and cross sectional size)

Position of water bearing stratum with reference to portal of tunnel .....

Log of tunnel: (Preceding table for log of well may be used, if desired. Give footage from portal and character of materials, as pertinent.)

13. **Pumping Equipment:**

(a) Pump Fairbanks-Morse (Make, type and size) Capacity 150 g.p.m.

(b) Motor 10 H.P. G.E. Pump & Motor combined (Type and horsepower)

14. Location of area irrigated or to be irrigated, or place of use if for purposes other than irrigation.

Township North or South	Range E. or W. of Willamette Meridian	Section	Forty-acre Tract	Number Acres To Be Irrigated	Date of Reclamation
3 S.	1-E	Sec 32	SW¼ of SW¼	23	May 10, 1955

15. If the ground water supply is supplemental to an existing water supply, identification of any application for a permit, permit, certificate or adjudicated right to appropriate water made or held by the registrant.

.....

.....

GR-264B

Township 3 S Range 1 E, W.M.

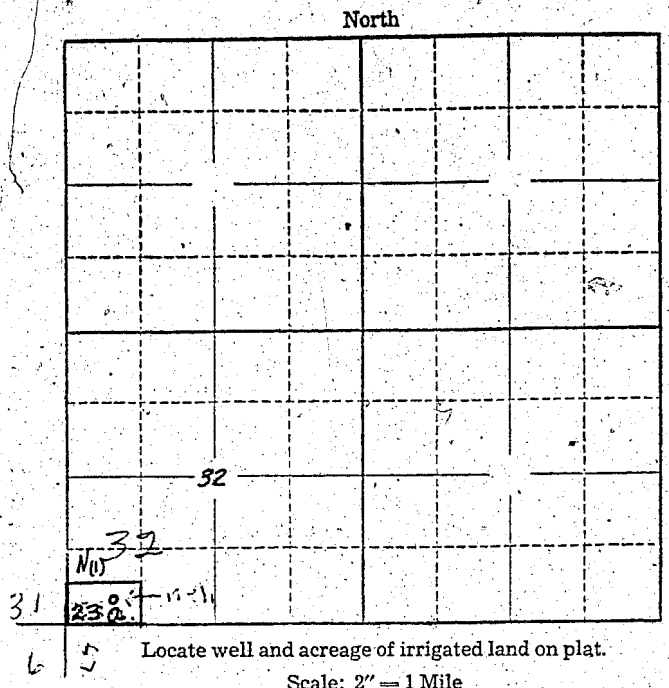

Locate well and acreage of irrigated land on plat.

Scale: 2" = 1 Mile

STATE OF OREGON
County of Clackamas } ss.

I, W F Cushing, being first duly sworn, do hereby certify that I have read the foregoing Registration Statement and that all of the items therein contained are true to the best of my knowledge and belief.

W F Cushing
(Signature of Registrant)

Subscribed and sworn to before me this 9th day of November, 1956

My commission expires Jan 24 1960

C E Johnson
(Notary Public)

(SEAL)

CERTIFICATE OF REGISTRATION

STATE OF OREGON
County of Marion } ss.

This is to certify that the foregoing Registration Statement was received in the office of the State Engineer on the 9th day of November, 1956, at 8 o'clock A.M. and has been duly recorded in said office in Book No. 2 of Registration Statements on page GR-264-C

~~Construction work completed by X-X-X-X-X-X-X-X-X-19-X-and the water can be put to beneficial use by X-X-X-X-X-X-X-X-X-19-X-~~

Witness my hand this 15th day of January, 1957

Lewis A. Stanley
(State Engineer)

By
(Deputy)

GR-264C