

Registration Statement

OF CLAIMANT OF RIGHT TO APPROPRIATE GROUND WATER

RECEIVED
APR 20 1950
STATE ENGINEER
ALBANY, OREGON

TO THE STATE ENGINEER OF OREGON:

I, Edward L. Pettier

of 150 E. Hilliard Lane, Eugene County of Lane

State of Oregon, do hereby make application for a certificate of registration as evidence of a right to appropriate ground water.

1. Source from which water is withdrawn is Pump well
(Flowing well, pump well, infiltration trench, or tunnel)

2. Location is: 2 miles from Eugene - River Rd area
(Approximate distance and direction from nearest city or town)

and is more particularly described as follows: 2050 feet wide by 400 feet north from E 1/4 corner

(a) See plat attached
(Give distance and bearing to corner of section or other legal subdivision)

being within SW 1/4 NE 1/4 of Sec. 24, Twp. 17S, Rge. 4W
(Smallest legal subdivision) (N. or S.) (E. or W.)

or (b) within limits of recorded platted property, town or city:

in Lot A, Block 1 of Oakleigh
(Name of plat or addition)

County of Lane
(If within city or town, give name)

3. Construction Work was begun on May 1954; was completed on May 1954
(Date) (Date)

and the ground water claimed was first used for the purposes set out below on May 1954
(Date)

since which time the water has been used intermittently - no winter use
(Continuously or intermittently)

from May to October
(Date) (Date)

4. Quantity of water claimed and used is 35 gallons per minute; _____ acre feet per year.

5. Purpose or Purposes for which water is used Irrigation
(Domestic, irrigation, municipal, manufacturing, industrial, etc.)

6. Description of Well: Depth 20 feet. Type Driven
(Dug or drilled)

diameter 1 1/2 inches. Elevation of ground at well site 380 feet, mean sea level.
(As near as known)

Depth to water table 15 feet.

7. Capacity of Well: 35 g.p.m. with 2 feet drawdown.

_____ g.p.m. with _____ feet drawdown.


Date of test May 1954

If Flowing Well: Measured discharge _____ g.p.m. on _____
(Date)

Shut-in pressure at ground surface _____ lbs. per sq. in. on _____
(Date)

Water is controlled by _____
(Cap, valve, etc.)

Township 17S Range 4W W.M.
North

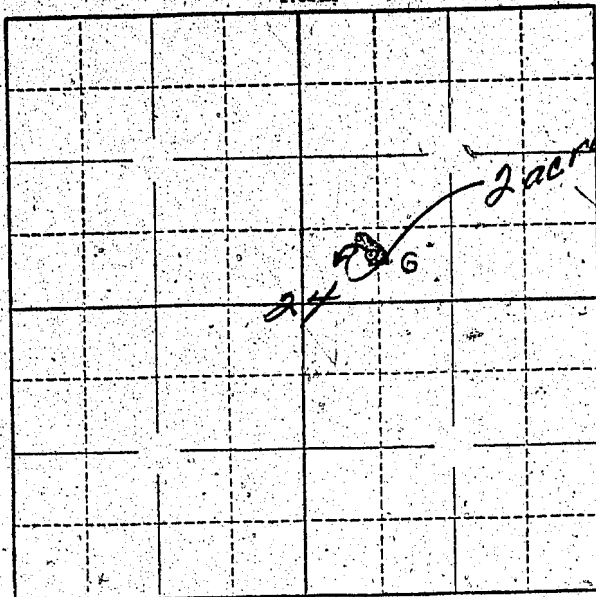

Locate well and acreage of irrigated land on plat.
Scale: 1/4 = 1 Mile

STATE OF OREGON

County of Lane } ss.

I, Edward L. R. Hick, being first duly sworn, do hereby certify that I have read the foregoing Registration Statement and that all of the items therein contained are true to the best of my knowledge and belief.

Edward L. R. Hick
(Signature of Registrant)

Subscribed and sworn to before me this 28 day of July, 1958

My commission expires June 23, 1961
Hayden L. Lane
(Notary Public)

(SEAL)

CERTIFICATE OF REGISTRATION

STATE OF OREGON

County of Marion } ss.

This is to certify that the foregoing Registration Statement was received in the office of the State Engineer on the 29th day of July, 1958, at 2:00 o'clock A. M. and has been duly recorded in said office in Book No. 17 of Registration Statements on page GR 4076

Witness my hand this 16th day of May, 1960

LEWIS A. STANLEY
(State Engineer)

By Max E. Rogers
(Deputy)

\$ 15.00

GR 4076