

Registration Statement

OF CLAIMANT OF RIGHT TO APPROPRIATE GROUND WATER

TO THE STATE ENGINEER OF OREGON:

I, L.R. LANE
of Rt 2 Box 167 BORING County of Clackamas
(Mailing address)
State of OREGON, do hereby make application for a certificate of registration as evidence of a right to appropriate ground water.

1. Source from which water is withdrawn is PUMP WELL
(Flowing well, pump well, infiltration trench, or tunnel)

2. Location is: 3 mi. NE from BORING
(Approximate distance and direction from nearest city or town)

and is more particularly described as follows:

(a) S 55° 0' W 2320' from NE COR Sec 30
(Give distance and bearing to corner of section or other legal subdivision)

being within SW / NE of Sec. 30, Twp. 1S, Rge. 4E
(Smallest legal subdivision) (N. or S.) (E. or W.)

or (b) within limits of recorded platted property, town or city:

in Lot _____ Block _____ of _____
(Name of plat or addition)

County of _____
(If within city or town, give name)

3. Construction Work was begun on Apr 1950; was completed on May 1950
(Date) (Date)

and the ground water claimed was first used for the purposes set out below on June 1950
(Date)

since which time the water has been used Intermittently
(Continuously or Intermittently)

from May to SEPT
(Date) (Date)

4. Quantity of water claimed and used is 66 gallons per minute; 40 acre feet per year.

5. Purpose or Purposes for which water is used Irrigation

(Domestic, irrigation, municipal, manufacturing, industrial, etc.)

6. Description of Well: Depth 194 feet. Type DRILLED
(Dug or drilled)

diameter 8" inches. Elevation of ground at well site 200 feet, mean sea level.
(As near as known)

Depth to water table 80' feet.

7. Capacity of Well: Not Known g.p.m. with _____ feet drawdown.

_____ g.p.m. with _____ feet drawdown.


Date of test _____

If Flowing Well: Measured discharge _____ g.p.m. on _____
(Date)

Shut-in pressure at ground surface _____ lbs. per sq. in. on _____
(Date)

Water is controlled by _____
(Cap, valve, etc.)

Township 15 Range 4E, W.M.
North

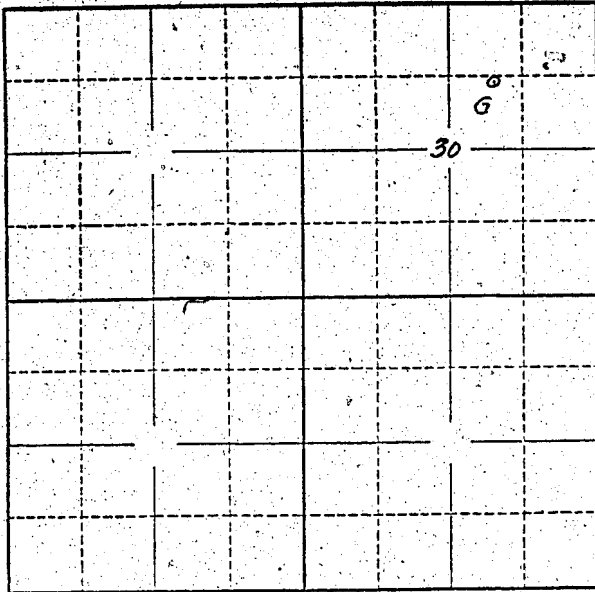

Locate well and acreage of irrigated land on plat.
Scale: 2" - 1 Mile

STATE OF OREGON

County of Multnomah } ss.

I, [Signature], being first duly sworn, do hereby certify that I have read the foregoing Registration Statement and that all of the items therein contained are true to the best of my knowledge and belief.

(Signature of Registrant)

Subscribed and sworn to before me this 26 day of July, 1958

My commission expires Oct 10 1959

(Notary Public)

(SEAL)

CERTIFICATE OF REGISTRATION

STATE OF OREGON

County of Marion } ss.

This is to certify that the foregoing Registration Statement was received in the office of the State Engineer on the 29th day of July, 1958, at 8:00 o'clock A.M. and has been duly recorded in said office in Book No. 12 of Registration Statements on page GR-2753

Witness my hand this 25th day of May, 1959

(State Engineer)

By [Signature] (Deputy)

GR - 2753

\$15.00