

Registration Statement

OF CLAIMANT OF RIGHT TO APPROPRIATE GROUND WATER

TO THE STATE ENGINEER OF OREGON:

I, Raymond G. Kolb

of 2150 Hwy 99E Junction City County of Lane

(Mailing address)

State of Oregon, do hereby make application for a certificate of registration as evidence of a right to appropriate ground water.

1. Source from which water is withdrawn is Driven Well

(Flowing well, pump well, infiltration trench, or tunnel)

2. Location is: 2 1/2 Mile North East of Junction City

(Approximate distance and direction from nearest city or town)

and is more particularly described as follows:

(a) 800' West and 270' South of section corner 17N6 20E1

(Give distance and bearing to corner of section or other legal subdivision)

being within NE 1/4 of NE 1/4 of Sec. 20, Twp. 15 South, Rge. 4 West

(Smallest legal subdivision)

(N. or S.)

(E. or W.)

or (b) within limits of recorded platted property, town or city:

in Lot 7, Block _____ of _____

(Name of plat or addition)

County of _____

(If within city or town, give name)

3. Construction Work was begun on April 1950; was completed on April 1950

(Date)

(Date)

and the ground water claimed was first used for the purposes set out below on June 1950

(Date)

since which time the water has been used Intermittently

(Continuously or Intermittently)

from June 1950 to Aug 1957

(Date)

(Date)

4. Quantity of water claimed and used is 190 gallons per minute; 3 acre feet per year.

5. Purpose or Purposes for which water is used Irrigation

(Domestic, irrigation, municipal, manufacturing, industrial, etc.)

6. Description of Well: Depth 22 feet. Type Driven

(Dug or drilled)

diameter 4" inches. Elevation of ground at well site 200 feet, mean sea level.

(As near as known)

Depth to water table 15 feet.

7. Capacity of Well: 200 g.p.m. with 0 feet drawdown.

_____ g.p.m. with _____ feet drawdown.

Date of test No test

If Flowing Well: Measured discharge _____ g.p.m. on _____

(Date)


Shut-in pressure at ground surface _____ lbs. per sq. in. on _____

(Date)

Water is controlled by _____

(Cap, valve, etc.)

Township 15S Range 4W W.M.
North

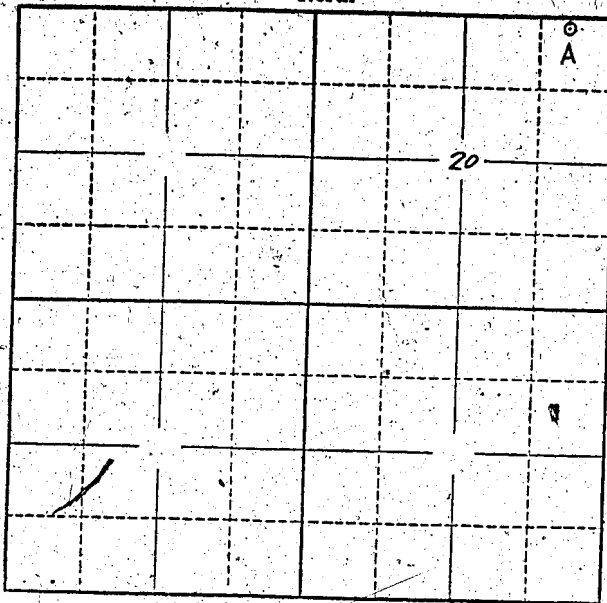

Locate well and acreage of irrigated land on plat.
Scale: 2" = 1 Mile

STATE OF OREGON

County of Lane } ss.

I, Raymond G. Kolb, being first duly sworn, do hereby certify that I have read the foregoing Registration Statement and that all of the items therein contained are true to the best of my knowledge and belief.

Raymond G. Kolb
(Signature of Registrant)

Subscribed and sworn to before me this 3rd day of April, 1958

My commission expires March 13, 1961

[Signature]
(Notary Public)

(SEAL)

CERTIFICATE OF REGISTRATION

STATE OF OREGON }
County of Marion } ss.

This is to certify that the foregoing Registration Statement was received in the office of the State Engineer on the 29th day of July, 1958, at 8.00 o'clock A.M. and has been duly recorded in said office in Book No. 12 of Registration Statements on page GR 2754

Witness my hand this 25th day of May, 1959

Lewis A. Stanley
(State Engineer)

By _____
(Deputy)

GR - 2754

4.500