RECEIVED 1955

REGISTRATION NO. GR-293

Registration Statement

CERTIFICATE NO. GR-265

OF CLAIMANT OF RIGHT TO APPROPRIATE GROUND WATER

(Under Chapter 708, Oregon Laws 1955.)

TO THE STATE ENGINEER OF OREGON:

I, C.R. Crist,

of Corvallis County of Benton

State of Oregon, do hereby make application for a certificate of registration as evidence of a right to appropriate ground water.

1. **Source** from which water is withdrawn is pump well (Flowing well, pump well, infiltration trench, or tunnel)

2. **Location** is: 2½ miles east of Corvallis via Hwy. 20 (Approximate distance and direction from nearest city or town);

and is more particularly described as follows:

(a) 26.764 ch. W. & 8.94 ch. N. of SE cor. D.L.C. #48 (Give distance and bearing to corner of section or other legal subdivision)

being within NE1/4 of SE1/4 (Smallest legal subdivision) of Sec. 19, Twp. 11S (N. or S.), Rge. 4W (E. or W.)

or (b) within limits of recorded platted property, town or city:

in Lot ....., Block ..... of ..... (Name of plat or addition)

..... (If within city or town, give name) County of .....

3. **Construction Work** was begun on 1952 (Date); was completed on 1952 (Date)

and the ground water claimed was first used for the purposes set out below on 1952 (Date),

since which time the water has been used continuously (Continuously or intermittently)

from 1952 (Date) to present (Date)

4. **Quantity** of water claimed and used is 200 gallons per minute; 50 acre feet per year.

5. **Purpose or Purposes** for which water is used irrigation

(Domestic, irrigation, municipal, manufacturing, industrial, etc.)

6. **Description of Well:** Depth 33 feet. Type drilled (Dug or drilled)

diameter 6 inches. Elevation of ground at well site 200 (As near as known) feet, mean sea level.

Depth to water table 11 feet.

7. **Capacity of Well:** unknown g.p.m. with ..... feet drawdown.

..... g.p.m. with ..... feet drawdown.

Date of test .....

If Flowing Well: Measured discharge ..... g.p.m. on ..... (Date)

Shut-in pressure at ground surface ..... lbs. per sq. in. on ..... (Date)

Water is controlled by ..... (Cap, valve, etc.)

8. **Casing:** (Give diameter, commercial specifications and depth below ground surface of each casing size.)

6 inch diameter from 0 to 33 feet

inch diameter from to feet

inch diameter from to feet

inch diameter from to feet

Describe and show depth of shoe, plug, adapter, liner or other details: unknown

9. **Perforated Casings or Screens:**

unknown from to
(Number per foot and size of perforations, or describe screen)

from to

from to

from to

10. **Log of Well:** (Describe each stratum or formation clearly, indicate if water bearing, and give thickness and depth as indicated.)

MATERIAL	Thickness (Feet)	Depth to Bottom (Feet)
unknown		

GR-265 A

If log of well is not available, give name and address of driller. .....

Raymond C. Gellatly, Philomath

11. **Infiltration Trench:** Covered or open .....

Dimensions: Length ..... ft. Minimum depth ..... ft. Maximum depth ..... ft.

Bottom width ..... ft. Discharge ..... g.p.m. Date of test .....

12. **Tunnel:** Type of lining .....

Dimensions: .....
(Length, course, and cross sectional size)

Position of water bearing stratum with reference to portal of tunnel .....

.....

Log of tunnel: (Preceding table for log of well may be used, if desired. Give footage from portal and character of materials, as pertinent.)

13. **Pumping Equipment:**

(a) Pump Pacific centrifugal 4" (Make, type and size) Capacity unknown g.p.m.

(b) Motor 10 hp. Electric (Type and horsepower)

14. Location of area irrigated or to be irrigated, or place of use if for purposes other than irrigation.

Township North or South	Range E. or W. of Willamette Meridian	Section	Forty-acre Tract	Number Acres To Be Irrigated	Date of Reclamation
11S	4W	19	NE of SE	19.5	Previously irrigated
"	"	"	SE of SE	2.9	from surface water
"	"	"	~~SW of SE~~	~~1.0~~	~~dating back to~~ 1940
"	"	"	NW of SE	1.4	or before
				24.8	

15. If the ground water supply is supplemental to an existing water supply, identification of any application for a permit, permit, certificate or adjudicated right to appropriate water made or held by the registrant.

unknown

GR-265-B

Township 11 S Range 4 W, W.M.

North

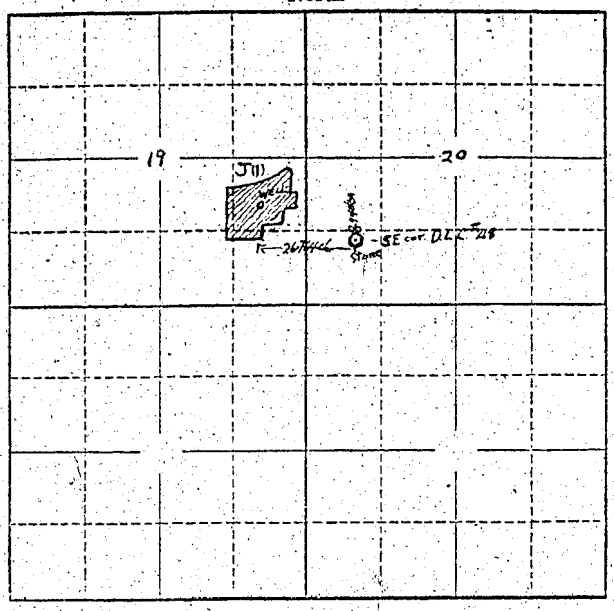

Locate well and acreage of irrigated land on plat.

Scale: 2" = 1 Mile

STATE OF OREGON
County of Benton } ss.

I, C R Crist, being first duly sworn, do hereby certify that I have read the foregoing Registration Statement and that all of the items therein contained are true to the best of my knowledge and belief.

C. R. Crist
(Signature of Registrant)

Subscribed and sworn to before me this 9th day of November, 19 56

My commission expires

Anne D Hawet
(Notary Public)

(SEAL)

CERTIFICATE OF REGISTRATION

STATE OF OREGON
County of Marion } ss.

This is to certify that the foregoing Registration Statement was received in the office of the State Engineer on the 9th day of November, 19 56, at 8 o'clock A. M. and has been duly recorded in said office in Book No. 2 of Registration Statements on page GR-265-C

~~Examined and compared~~

Witness my hand this 15th day of January, 19 57

Lewis A. Stanley
(State Engineer)

By
(Deputy)

GR-265C