

Registration Statement

OF CLAIMANT OF RIGHT TO APPROPRIATE GROUND WATER

TO THE STATE ENGINEER OF OREGON:

I, BEN H. PRUITT
of 5790 HIGHBANKS RD. SPRINGFIELD County of LANE
(Mailing address)

State of OREGON, do hereby make application for a certificate of registration as evidenced of a right to appropriate ground water.

1. Source from which water is withdrawn is PUMP WELL
(Flowing well, pump well, infiltration trench, or tunnel)

2. Location is: 6 MILE E SPRINGFIELD
(Approximate distance and direction from nearest city or town)

and is more particularly described as follows:

(a) WELL IN SEC 28 AND 360' N of INTERSECTION of SEC 28-27-33-34 and 20' W
(Give distance and bearing to corner of section or other legal subdivision)

being within SE 1/4 of SE 1/4 of Sec. 28, Twp. 17S Rge. 2W
(Smallest legal subdivision) (N. or S.) (E. or W.)

or (b) within limits of recorded platted property, town or city:

in Lot _____, Block _____ of None
(Name of plat or addition)

County of LANE
(If within city or town, give name)

3. Construction Work was begun on 1947, was completed on 1947
(Date) (Date)

and the ground water claimed was first used for the purposes set out below on 1947
(Date)

since which time the water has been used _____
(Continuously or intermittently)

from APRIL to OCT
(Date) (Date)

4. Quantity of water claimed and used is 384 gallons per minute; 55 acre feet per year.

5. Purpose or Purposes for which water is used IRRIG
(Domestic, irrigation, municipal, manufacturing, industrial, etc.)

6. Description of Well: Depth 20 1/2 feet. Type DRIVE
(Dug or drilled)
diameter _____ inches. Elevation of ground at well site _____ feet, mean sea level.
(As near as known)
Depth to water table 15 feet.

7. Capacity of Well: _____ g.p.m. with _____ feet drawdown.
_____ g.p.m. with _____ feet drawdown.

Date of test No test

If Flowing Well: Measured discharge _____ g.p.m. on _____
(Date)

Shut-in pressure at ground surface _____ lbs. per sq. in. on _____
(Date)

Water is controlled by _____
(Cap, valve, etc.)

8. Casing: (Give diameter, commercial specifications and depth below ground surface of each casing size.)

3 inch diameter from 0 to 20 feet
 inch diameter from to feet

Describe and show depth of shoe, plug, adapter, liner or other details:

9. Perforated Casings or Screens:

SHOT END from to
(Number per foot and size of perforations, or describe screen)
 from to
 from to
 from to

10. Log of Well: (Describe each stratum or formation clearly, indicate if water bearing, and give thickness and depth as indicated.)

MATERIAL	Thickness (Feet)	Depth to Bottom (Feet)
NONE		

If log of well is not available, give name and address of driller. Ben H. Pruitt
L. D. Gasler, 2776 Tauraton Road, Springfield, Mo.

11. Infiltration Trench: Covered or open
Dimensions: Length ft. Minimum depth ft. Maximum depth ft.
Bottom width ft. Discharge g.p.m. Date of test

12. Tunnel: Type of lining
Dimensions:
(Length, course, and cross sectional size)
Position of water bearing stratum reference to portal of tunnel

Log of tunnel: (Preceding table for log of well may be used, if desired. Give footage from portal and character of materials, as pertinent.)


13. Pumping Equipment:
(a) Pump FAIRBANKS MORSE CENT 4 1/2" Capacity 384 g.p.m.
(Make, type and size)
(b) Motor " 20 HP ELEC
(Type and horsepower)

14. Location of area irrigated or to be irrigated, or place of use if for purposes other than irrigation.

Township North or South	Range E. or W. of Willamette Meridian	Section	Forty-acre Tract	Number Acres To Be Irrigated	Date of Reclamation
<u>T17S</u>	<u>R2W</u>	<u>28</u>	<u>SE 1/4 of SE 1/4</u>	<u>22.0</u>	<u>1947</u>

15. If the ground water supply is supplemental to an existing water supply, identification of any application for a permit, permit, certificate or adjudicated right to appropriate water made or held by the registrant.

Township N 7 S Range 3 W W.M.
North

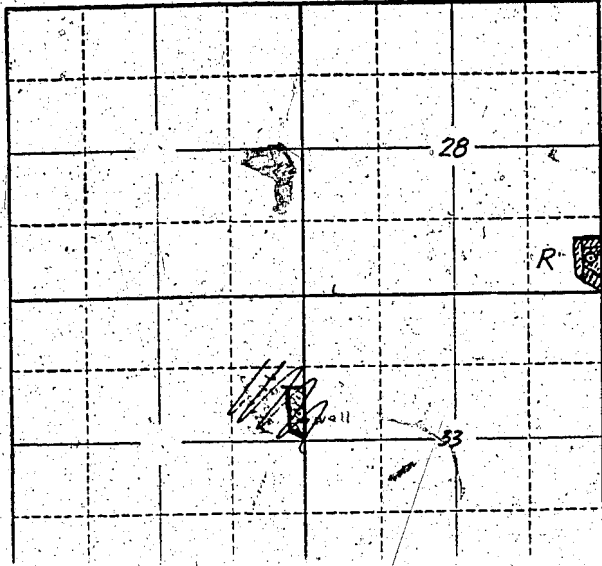

ENCLOSED

STATE OF OREGON

County of Lane Cal } ss.

I, Ben H. Pruitt, being first duly sworn, do hereby certify that I have read the foregoing Registration Statement and that all of the items therein contained are true to the best of my knowledge and belief.

Ben H. Pruitt
(Signature of Registrant)

Subscribed and sworn to before me this 28 day of July, 1958

My commission expires My Commission Expires Jan. 9, 1961

Charles Wesley Hall
(Notary Public)

(SEAL)

CERTIFICATE OF REGISTRATION

STATE OF OREGON

County of Marion } ss.

This is to certify that the foregoing Registration Statement was received in the office of the State Engineer on the 29 day of July, 1958, at 8:00 o'clock A. M. and has been duly recorded in said office in Book No. 12 of Registration Statements on page GR 2765

Witness my hand this 25th day of May, 1959

Lewis A. Stanley
(State Engineer)

By _____ (Deputy)

GR 2765

*15.00