

# Registration Statement

## OF CLAIMANT OF RIGHT TO APPROPRIATE GROUND WATER

TO THE STATE ENGINEER OF OREGON:

I, Vernon M. Wilson  
of Rt. 2 Box 477 Salem, Ore County of Marion  
(Mailing address)

State of Oregon do hereby make application for a certificate of registration as evidence of a right to appropriate ground water.

1. Source from which water is withdrawn is Pump Well  
(Flowing well, pump well, infiltration trench, or tunnel).

2. Location is: 4 Miles S.E. of Braks, Ore.  
(Approximate distance and direction from nearest city or town)

and is more particularly described as follows:

(a) 695' S. and 1880' E of NW Corner of NW 1/4 of NE 1/4  
(Give distance and bearing to corner of section or other legal subdivision)  
being within NW 1/4 of NE 1/4 of Sec. 27, Twp. 6S, Rge. 3W  
(Smallest legal subdivision) (N. or S.) (E. or W.)

or (b) within limits of recorded platted property, town or city:

in Lot \_\_\_\_\_, Block \_\_\_\_\_ of \_\_\_\_\_  
(Name of plat or addition)  
County of \_\_\_\_\_  
(If within city or town, give name)

3. Construction Work was begun on March 30, 1954 was completed on Apr. 6, 1954  
(Date) (Date)

and the ground water claimed was first used for the purposes set out below on Apr. 6, 1954  
(Date)

since which time the water has been used Intermittently  
(Continuously or intermittently)

from Apr. 6, 1954 to July 25, 1958  
(Date) (Date)

4. Quantity of water claimed and used is 200 gallons per minute; 54 acre feet per year.

5. Purpose or Purposes for which water is used Irrigation

(Domestic, irrigation, municipal, manufacturing, industrial, etc.)

6. Description of Well: Depth 123 feet. Type Drilled  
(Dug or drilled)

diameter 8 inches. Elevation of ground at well site \_\_\_\_\_ feet, mean sea level.  
(As near as known)

Depth to water table 46 feet.

7. Capacity of Well: 450 g.p.m. with 98 feet drawdown.  
\_\_\_\_\_ g.p.m. with \_\_\_\_\_ feet drawdown.

Date of test Apr. 6, 1954

If Flowing Well: Measured discharge \_\_\_\_\_ g.p.m. on \_\_\_\_\_  
(Date)

Shut-in pressure at ground surface \_\_\_\_\_ lbs. per sq. in. on \_\_\_\_\_  
(Date)

Water is controlled by \_\_\_\_\_  
(Cap, valve, etc.)

8. Casing: (Give diameter, commercial specifications and depth below ground surface of each casing size.)

8 inch diameter ..... from 0 to 120 feet  
 ..... inch diameter ..... from ..... to ..... feet  
 ..... inch diameter ..... from ..... to ..... feet  
 ..... inch diameter ..... from ..... to ..... feet

Describe and show depth of shoe, plug, adapter, liner or other details: .....

9. Perforated Casings or Screens:

Unknown ..... from 82' to 120'  
(Number per foot and size of perforations, or describe screen)  
 ..... from ..... to .....  
 ..... from ..... to .....  
 ..... from ..... to .....

10. Log of Well: (Describe each stratum or formation clearly, indicate if water bearing, and give thickness and depth as indicated.)

MATERIAL	Thickness (Feet)	Depth to Bottom (Feet)
Sub soil	3	13
Yellow silt	76	79
Sand	2	81
Cemented Gravel	12	93
Water-bearing Gravel	1	94
Cemented Gravel	27	121
Water <sup>Gravel</sup> and Sand	1	123
Blue Shale	2	125

If log of well is not available, give name and address of driller. ....

11. Infiltration Trench: Covered or open .....

Dimensions: Length ..... ft. Minimum depth ..... ft. Maximum depth ..... ft.

Bottom width ..... ft. Discharge ..... g.p.m. Date of test .....

12. Tunnel: Type of lining .....

Dimensions: .....  
(Length, course, and cross sectional size)

Position of water bearing stratum with reference to portal of tunnel .....

Log of tunnel: (Preceding table for log of well may be used, if desired. Give footage from portal and character of materials, as pertinent.)

13. Pumping Equipment:

(a) Pump Fairbanks Morse Turbine Capacity 200 g.p.m.  
(Make, type and size)

(b) Motor 10 HP 3  $\phi$  240 Volts  
(Type and horsepower)

14. Location of area irrigated or to be irrigated, or place of use if for purposes other than irrigation.


Township North or South	Range E. or W. of Willamette Meridian	Section	Forty-acre Tract	Number Acres To Be Irrigated	Date of Reclamation
G.S.	2.W	2.7	NW $\frac{1}{4}$ of NE $\frac{1}{4}$	48.11.3	Apr 6, 1959
"	"	"	NE $\frac{1}{4}$ NE $\frac{1}{4}$	6.7	"
				Total 18.0	"

15. If the ground water supply is supplemental to an existing water supply, identification of any application for a permit, permit, certificate or adjudicated right to appropriate water made or held by the registrant.

Township 6 S Range 2 W W.M.  
North

N 1/4 Corner Sec. 27

NE Corner Sec. 27

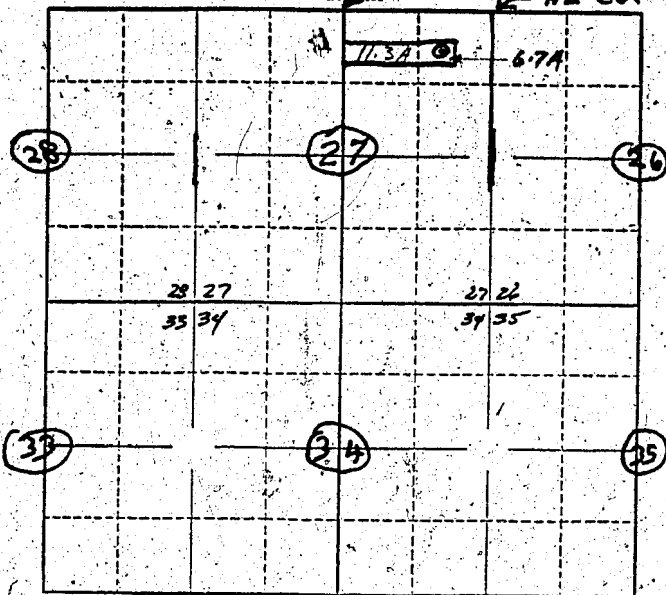

Locate well and acreage of irrigated land on plat.  
Scale: 2" = 1 Mile

STATE OF OREGON

County of Marion } ss.

I, VERNON M. WILSON, being first duly sworn, do hereby certify that I have read the foregoing Registration Statement and that all of the items therein contained are true to the best of my knowledge and belief.

[Signature]  
(Signature of Registrant)

Subscribed and sworn to before me this 25th day of July, 1958

My commission expires 11-29-59

[Signature]  
(Notary Public)

(SEAL)

**CERTIFICATE OF REGISTRATION**

STATE OF OREGON

County of Marion } ss.

This is to certify that the foregoing Registration Statement was received in the office of the State Engineer on the 29th day of July, 1958, at 8.00 o'clock A. M. and has been duly recorded in said office in Book No. 12 of Registration Statements on page GR-2767

Witness my hand this 25th day of May, 1959

[Signature]  
(State Engineer)

By \_\_\_\_\_  
(Deputy)

GR - 2767

\$15.00